

404 TACONIC MICROGRID - PHOTOVOLTAIC ENERGY SYSTEM

THIS 186.2 KWSTC, ROOF MOUNTED PHOTOVOLTAIC (PV) SYSTEM IS TO BE INSTALLED AT [REDACTED]
 THE ENERGY PRODUCED BY THE PV SYSTEM SHALL BE INTERCONNECTED WITH THE UTILITY GRID THROUGH THE EXISTING ON-SITE ELECTRICAL EQUIPMENT VIA
 A BACK-FED BREAKER IN THE MAIN SERVICE PANEL. THIS PROJECT INCLUDES 880 KWH OF ENERGY STORAGE BATTERIES.

SHEET INDEX

- T1.0 COVER
- T1.1 PROJECT NOTES
- A1.0 SITE PLAN
- E1.0 ELECTRICAL LAYOUT
- E1.1 ELECTRICAL ELEVATIONS
- E1.2 CONSTRUCTION DETAILS
- E1.3 CONSTRUCTION DETAILS
- E2.0 ELECTRICAL DIAGRAM
- E2.1 ELECTRICAL CALCULATIONS
- E3.0 SAFETY PLACARDS
- D1.0 EQUIPMENT DATA SHEETS

GOVERNING CODES & STANDARDS

- 2017 NATIONAL ELECTRICAL CODE
- 2015 INTERNATIONAL BUILDING CODE
- 2015 INTERNATIONAL ENERGY CONSERVATION CODE
- 2015 INTERNATIONAL MECHANICAL CODE
- UNDERWRITERS LABORATORIES (UL) STANDARDS
- OSHA 29 CFR 1910.269

COMPONENTS LIST

ELECTRICAL					
QTY	NAME	DESCRIPTION	QTY	NAME	DESCRIPTION
532	PV MODULE	SUNPOWER SPR-X21-350-BLK (TOTAL: 9,331 SQ. FT.)	1	FUSE BOX	480 VAC, 200 A, NEMA 3R
3	PV INVERTER	SOLETRIA PVI 50TL 50.0 KW, 480 VAC, 66.2 A	1	ZREC METER	480 VAC, 400 A, NEMA 3R
532	RAPID SHUTDOWN	APSMART RSD-S-PLC	1	ESS METER	480 VAC, 200 A, NEMA 3R
2	AC DISCONNECT	480 VAC, 400 A, NEMA 3R	1	TRANS-FORMER	150 KVA, NEMA 3R ESS-SIDE: 480 VAC, UTILITY-SIDE: 277/480 VAC
1	AC COM-BINER PANEL	480 VAC, 400 A, NEMA 3R	1	TRANS-FORMER	223 KVA, NEMA 3R BACKUP-SIDE: 120/208 VAC, UTILITY-SIDE: 277/480 VAC
1	AC COM-BINER PANEL	480 VAC, 400 A, NEMA 3R	1	TRANS-FORMER	300 KVA, NEMA 3R CUSTOMER-SIDE: 120/208 VAC, UTILITY-SIDE: 277/480 VAC
1	AC COM-BINER PANEL	480 VAC, 600 A, NEMA 3R	1	TRANS-FORMER	1 KVA, NEMA 3R PRIMARY-SIDE: 480 VAC, SECONDARY-SIDE: 120 VAC
1	AC COM-BINER PANEL	208 VAC, 400 A, NEMA 3R	1	MICROGRID CONTROLLER	ELM FIELDSIGHT CONTROLLER
1	AC COM-BINER PANEL	208 VAC, 800 A, NEMA 3R	1	ENERGY STORAGE SYSTEM	ELM MG125 ESS 125 KW, 220 KWH (110 KWH PER RACK), NEMA 3R
1	CONTACTOR	ABB AC NON REVERSING CONTACTOR 480 VAC, 600 A, NEMA 3R	3	BATTERY EXPANSION	ELM MG125 EXPANSION 220 KWH (110 KWH PER RACK), NEMA 3R
			1	SWITCHGEAR	480 VAC, 1200 A, NEMA 3R

SITE SPECIFICATIONS

- EXPOSURE CATEGORY: C
- RISK CATEGORY: II
- WIND SPEED (ASCE 7-10): 117 MPH
- SNOW LOAD (ASCE 7-10): 30 PSF

Contractor:

Project:
404 TACONIC MICROGRID

Project Details:
186.20 kWstc, 150.00 kW AC

Engineering Approval:

REVISIONS

DESCRIPTION	DATE	REV
60% DELIVERABLE	11/29/2021	1
90% DELIVERABLE	12/10/2021	2
PERMIT SET	1/25/2022	A
AHJ COMMENTS	3/11/2022	B
NEW EQUIPMENT PAD	10/7/2022	C
AS-BUILTS	8/13/2024	D

Sheet Title:

COVER

Sheet Number:

T1.0

Sheet Size:

ARCH D - 36" x 24"

Design & Drafting by:

ALEXANDER MORAN
Alexander Moran

"Always remember: never accept the world as it appears to be.
Dare to see it for what it could be."
- Harold Winston

Reviewed & Approved by:

RD



 
PARCEL MAP

1



AERIAL MAP

2



PROJECT LOCATION

VICINITY MAP



3

SYMBOL LEGEND		
SYMBOL	NAME	DESCRIPTION
	ROOFTOP PV MOD.	SPR X21 350 BLK DC
	FIRE SETBACK	FIRE REQUIRED PATHWAYS
	ROOF VENT	

NOTE:
 1. SITE DIMENSIONS DERIVED FROM GOOGLE AERIAL IMAGERY: RESOLUTION OF 6", DIMENSIONS PRECISE UP TO 1m (CE-90)
 2. BUILDING DIMENSIONS DERIVED FROM AS-BUILT STRUCTURAL OR ARCHITECTURAL DRAWINGS
 3. TRENCHING WITHIN 25 FEET OF SEPTIC TANKS WILL BE BACKFILLED WITH NON-FREE DRAINING MATERIAL AND WILL BE AT LEAST 5 FEET AWAY FROM THE TANKS
 4. TRENCHING WITHIN 25 FEET OF A WELL WILL BE BACKFILLED WITH NON-FREE DRAINING MATERIAL AND WILL BE AT LEAST 5 FEET AWAY FROM THE WELL

PV SYSTEM SUMMARY TABLE					
Array ID	Inverter ID	Mod Qty.	kW size	Tilt	Azimuth
1	Inv #1 # #2	266	93.10	23°	188°
2	Inv #1 # #3	266	93.10	23°	188°
Totals:		532	186.2		

SYSTEM SUMMARY:
 (532) SUNPOWER SPR-X21-350-BLK
 (3) SOLECTRIA PVI 50TL (480V)
 186.2 kWdc, 150 kW AC

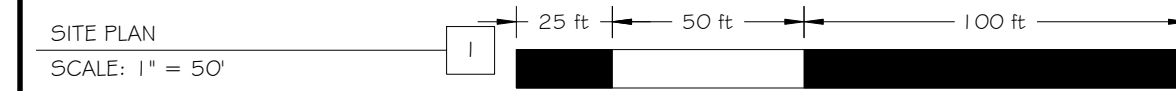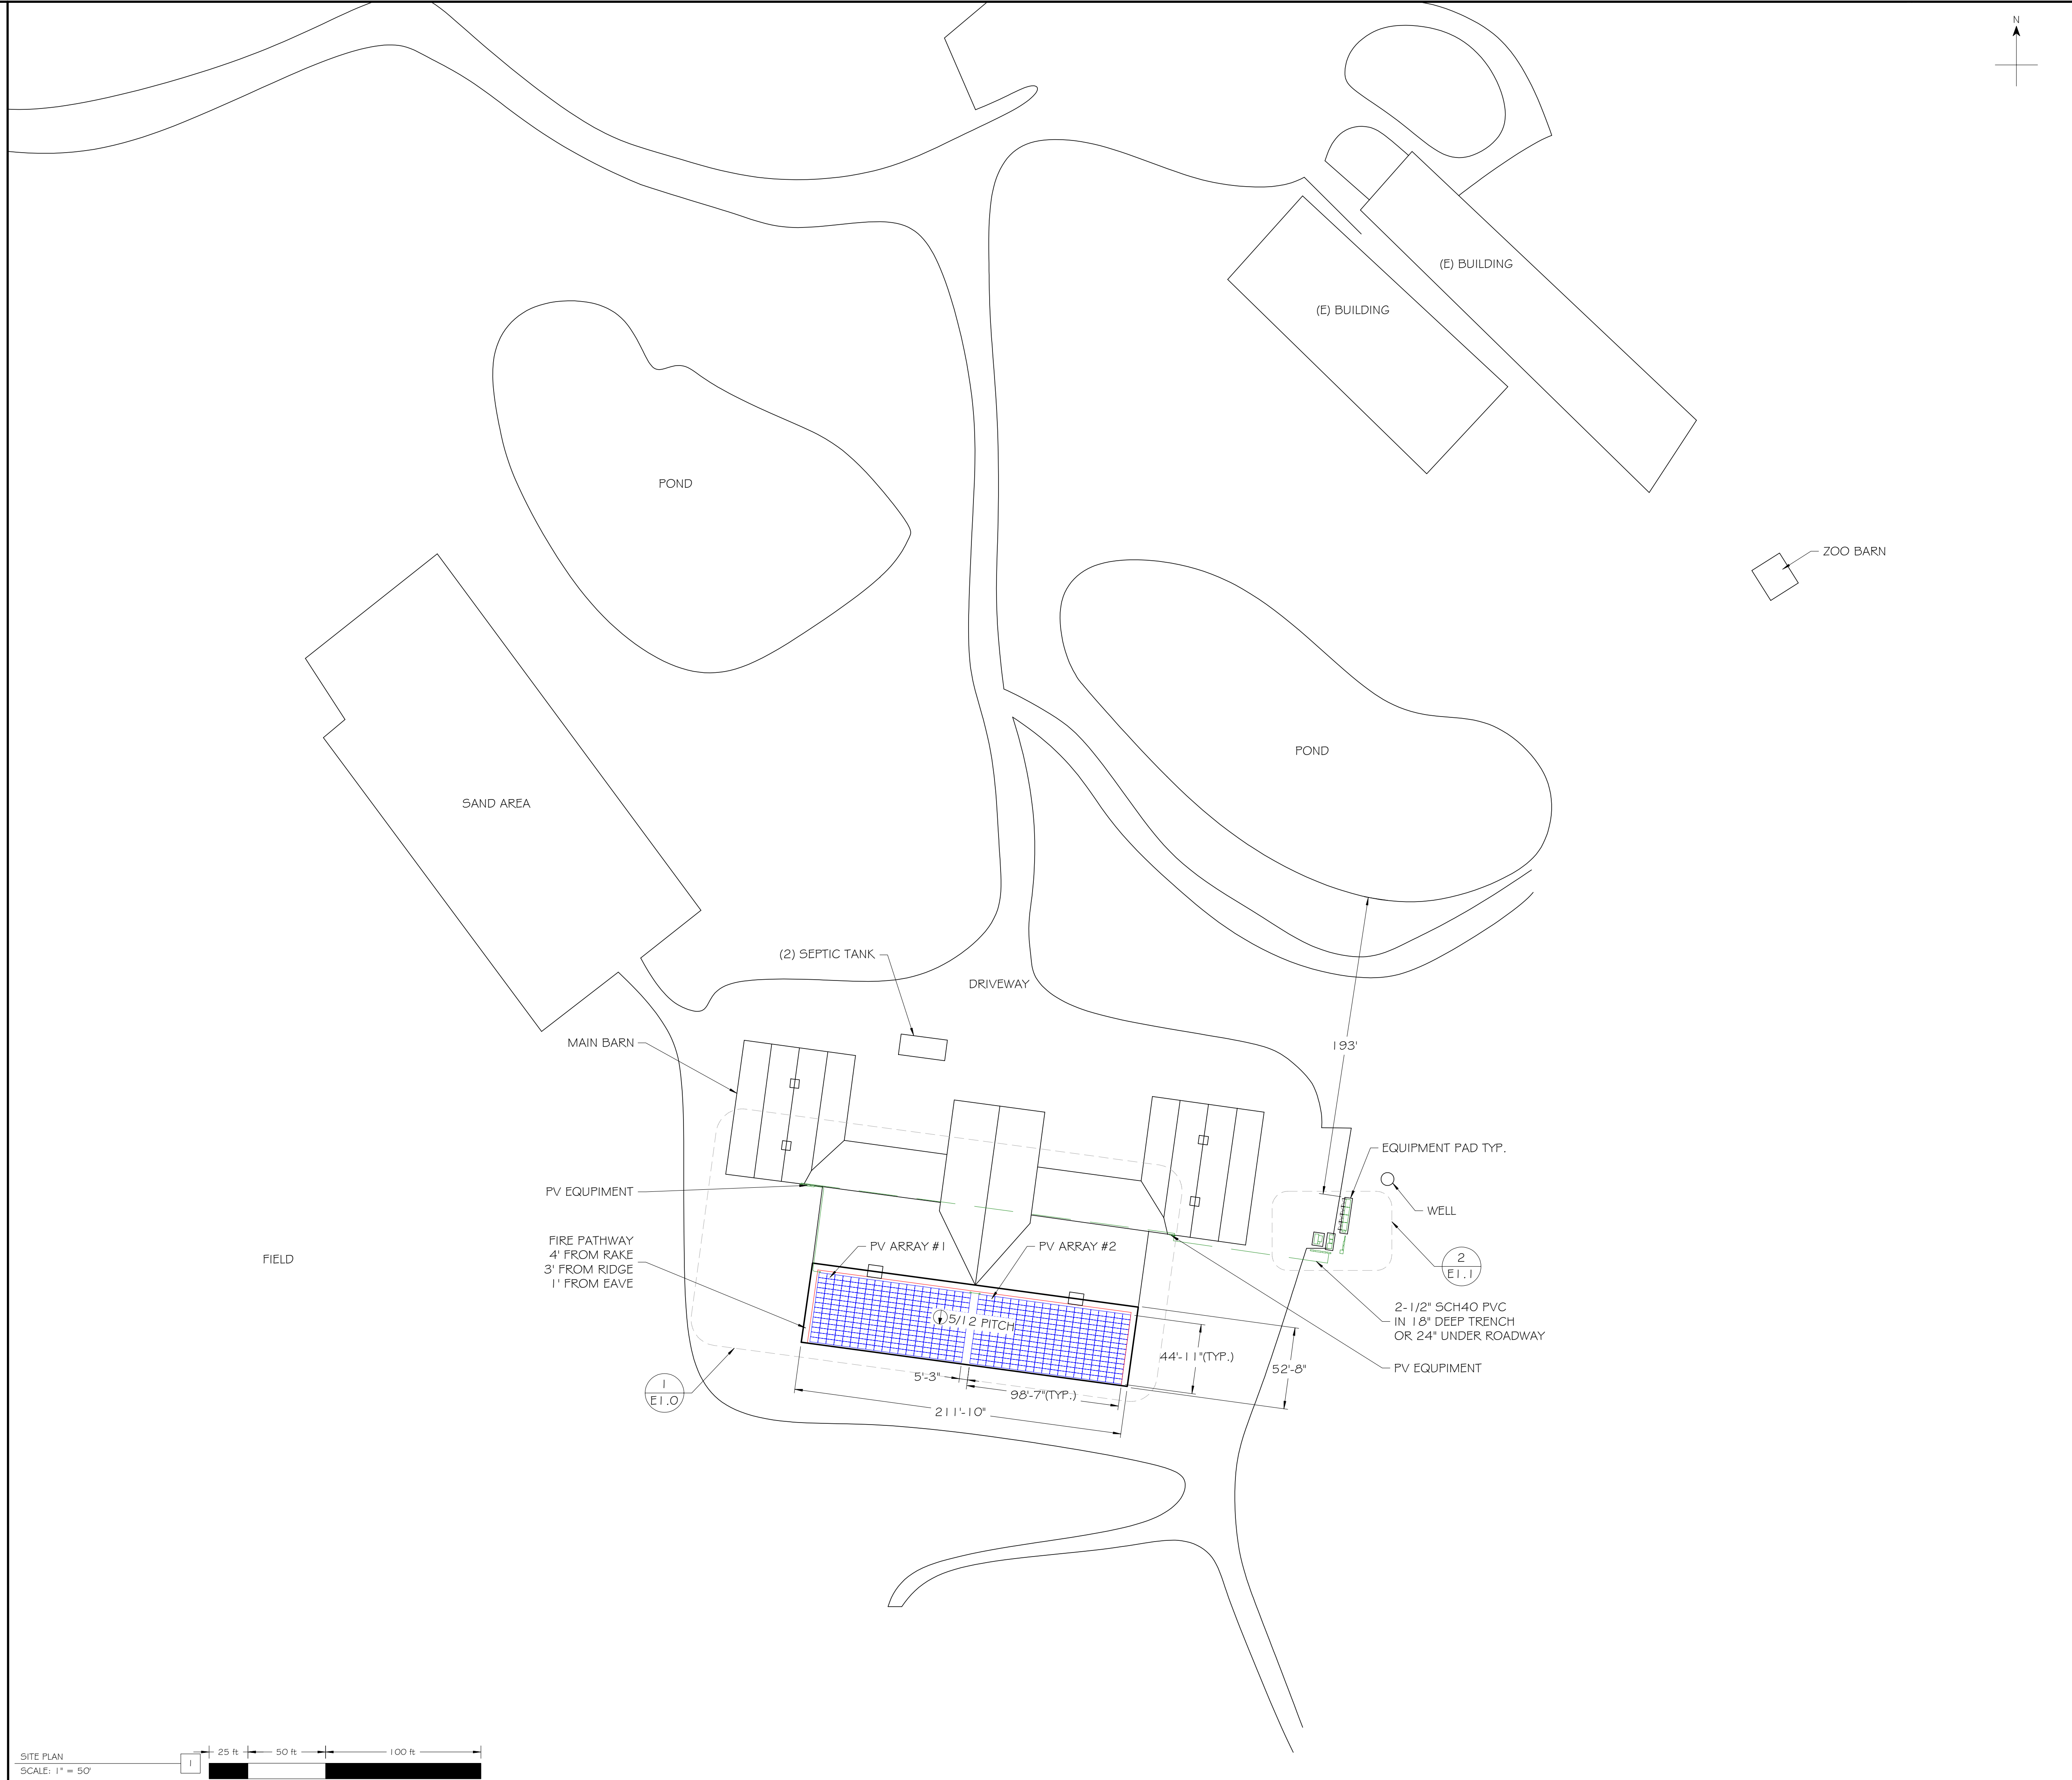

Contractor:

Project:
 404 TACONIC MICROGRID

Project Details:
 186.20 kWdc, 150.00 kW AC

Engineering Approval:

REVISIONS		
DESCRIPTION	DATE	REV
60% DELIVERABLE	11/29/2021	1
90% DELIVERABLE	12/10/2021	2
PERMIT SET	1/25/2022	A
AHJ COMMENTS	3/11/2022	B
NEW EQUIPMENT PAD	10/7/2022	C
AS-BUILTS	8/13/2024	D

Sheet Title:
 SITE PLAN



Sheet Number:
 A1.0

Sheet Size:
 ARCH D - 36" x 24"

Design & Drafting by:
 ALEXANDER MORAN
Alexander Moran
 "Always remember: never accept the world as it appears to be. Dare to see it for what it could be."
 - Harold Winston

Reviewed & Approved by:
 RD

SYMBOL LEGEND		
SYMBOL	NAME	DESCRIPTION
	ROOFTOP PV MOD.	SPR X21 350 BLK DC
	ROOF VENT	

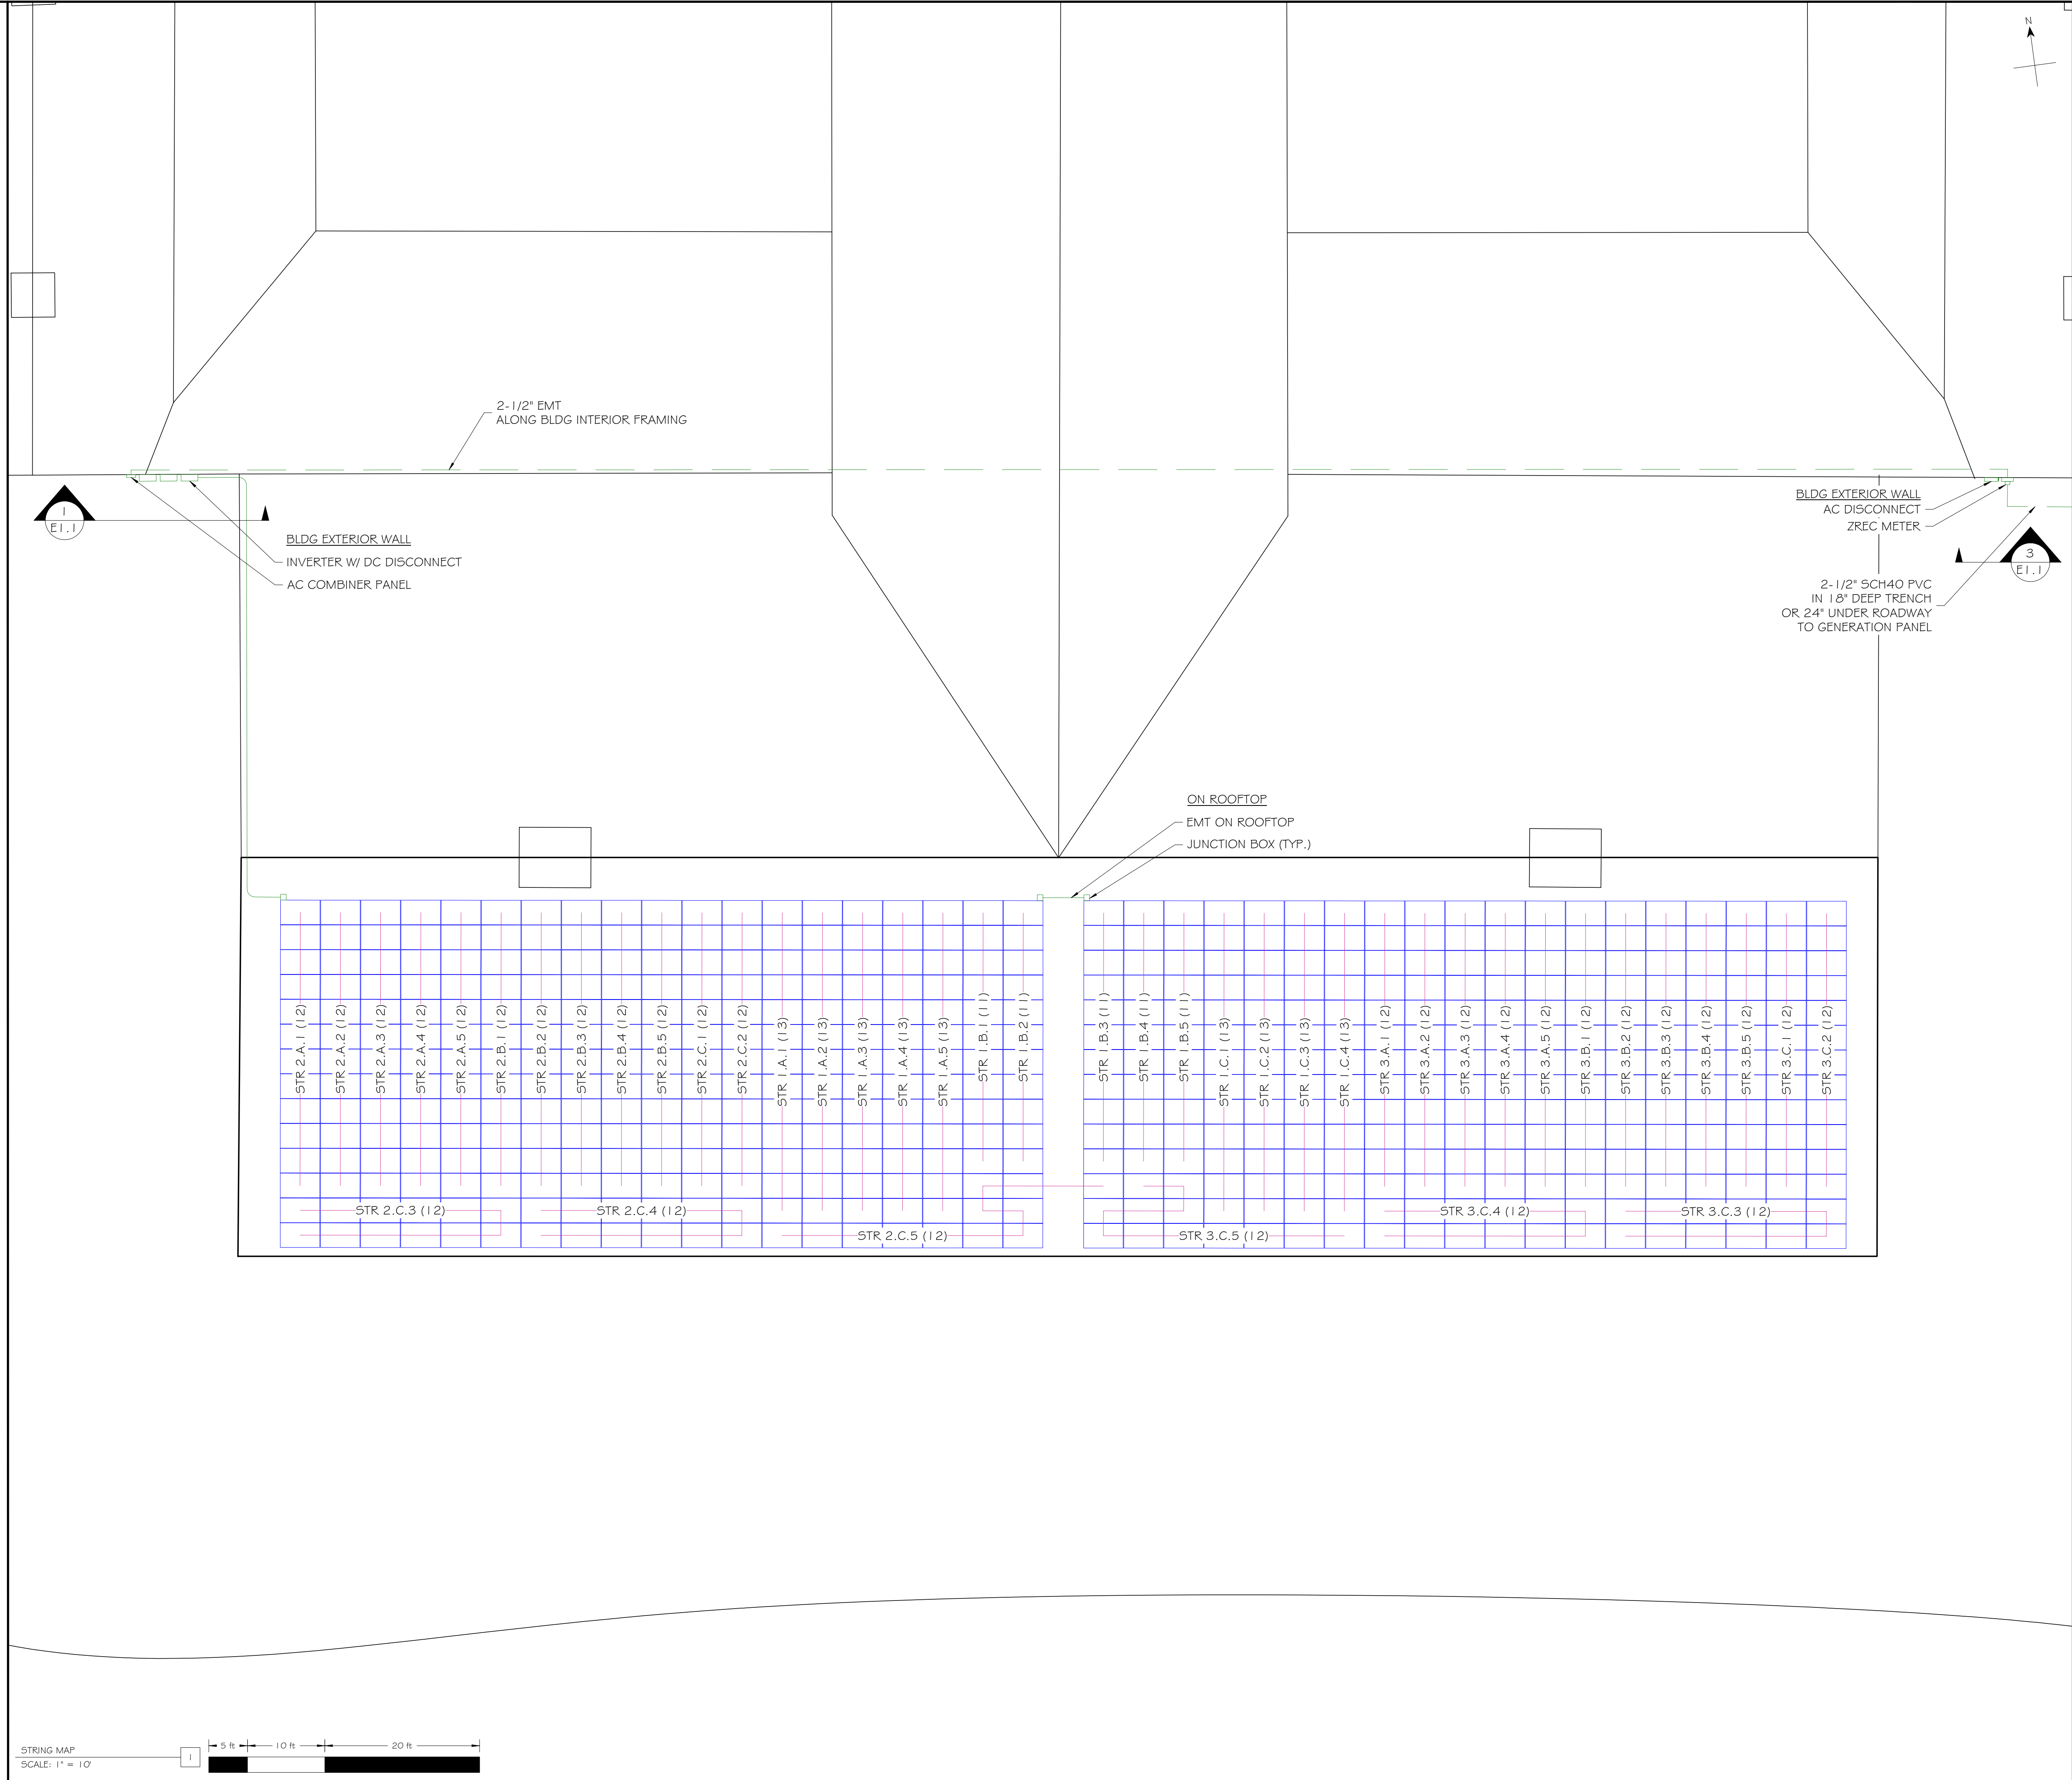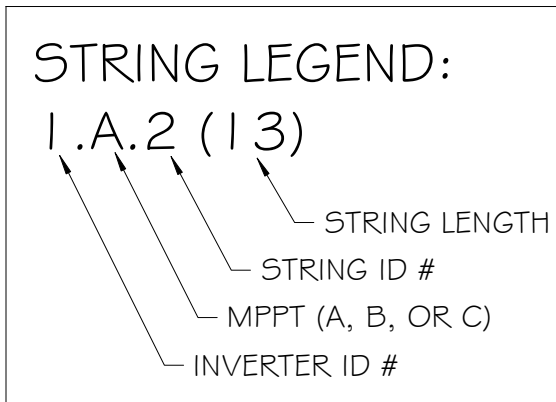

Contractor:

Project:
404 TACONIC MICROGRID

Project Details:
186.20 kWdc, 150.00 kW AC

Engineering Approval:

REVISIONS		
DESCRIPTION	DATE	REV
60% DELIVERABLE	11/29/2021	1
90% DELIVERABLE	12/10/2021	2
PERMIT SET	1/25/2022	A
AHJ COMMENTS	3/11/2022	B
NEW EQUIPMENT PAD	10/7/2022	C
AS-BUILTS	8/13/2024	D


Sheet Title:
ELECTRICAL LAYOUT


Sheet Number:
E1.0

Sheet Size:
ARCH D - 36" x 24"


Design & Drafting by:
ALEXANDER MORAN
Alexander Moran
"Always remember: never accept the world as it appears to be. Dare to see it for what it could be."
- Harold Winston

Reviewed & Approved by:
RD

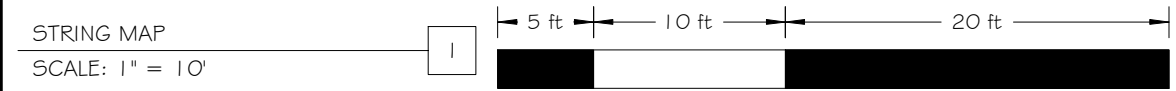


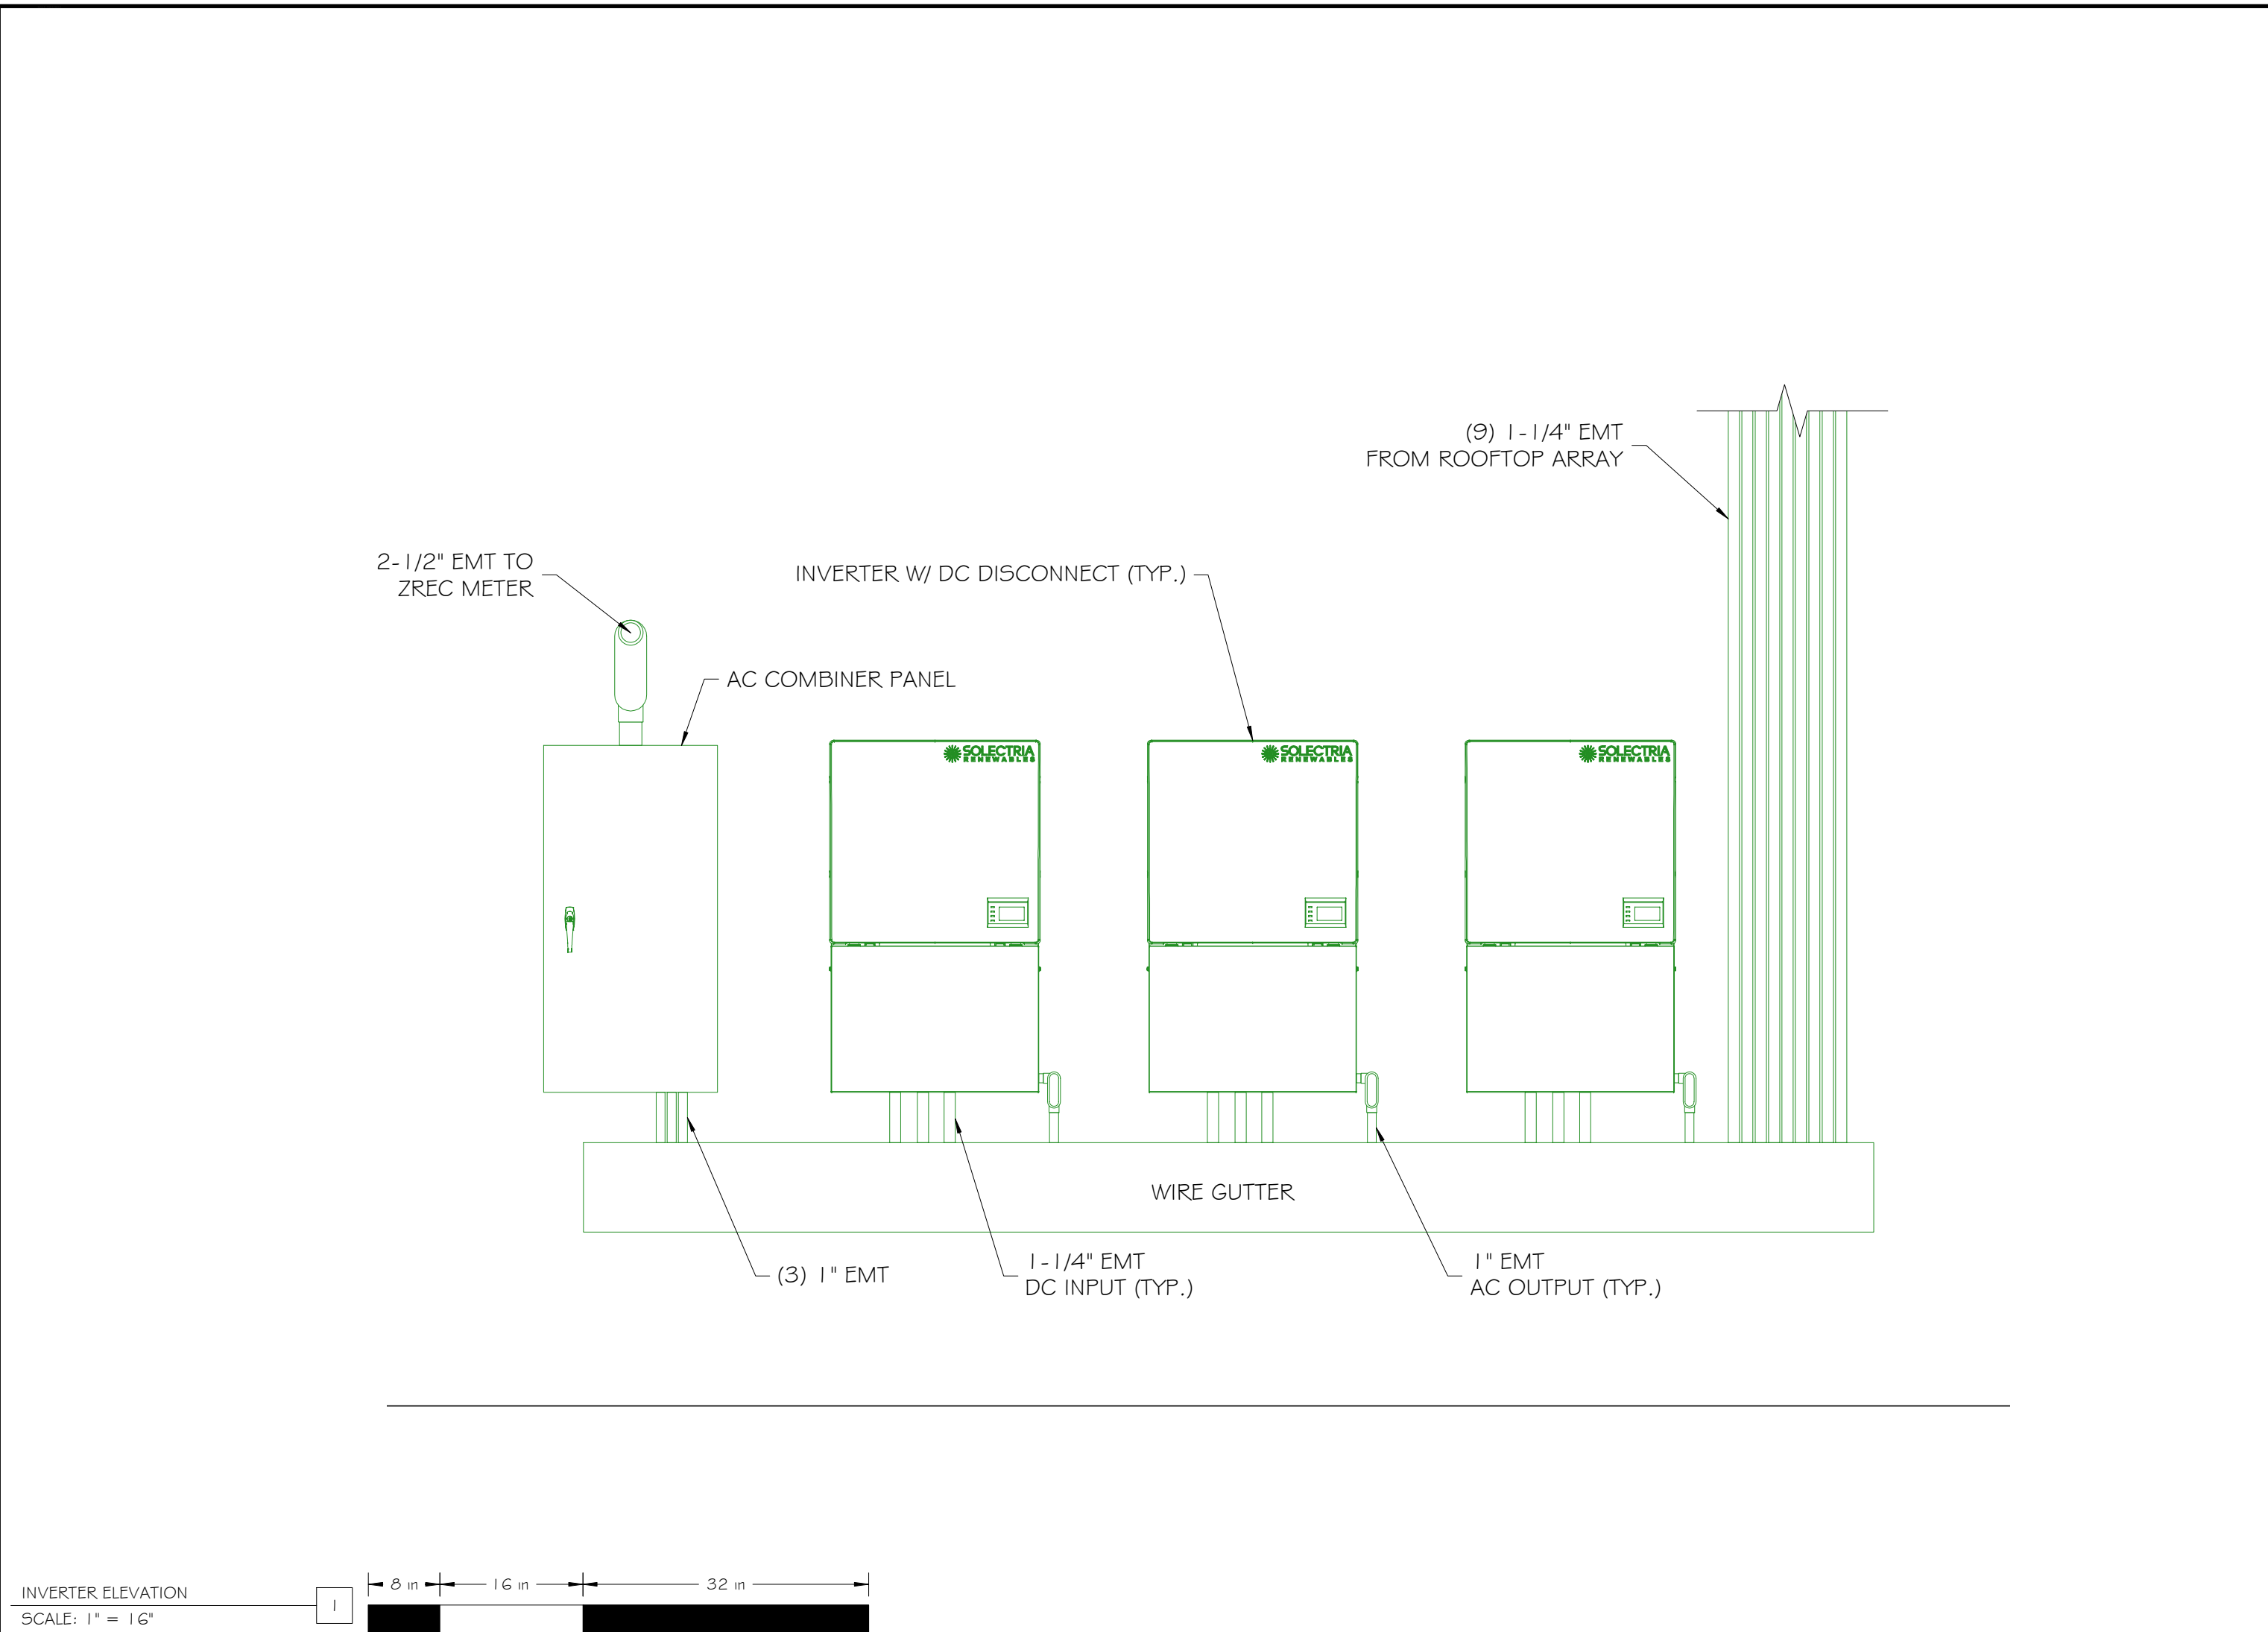


INVERTER ELEVATION
SCALE: 1" = 16"

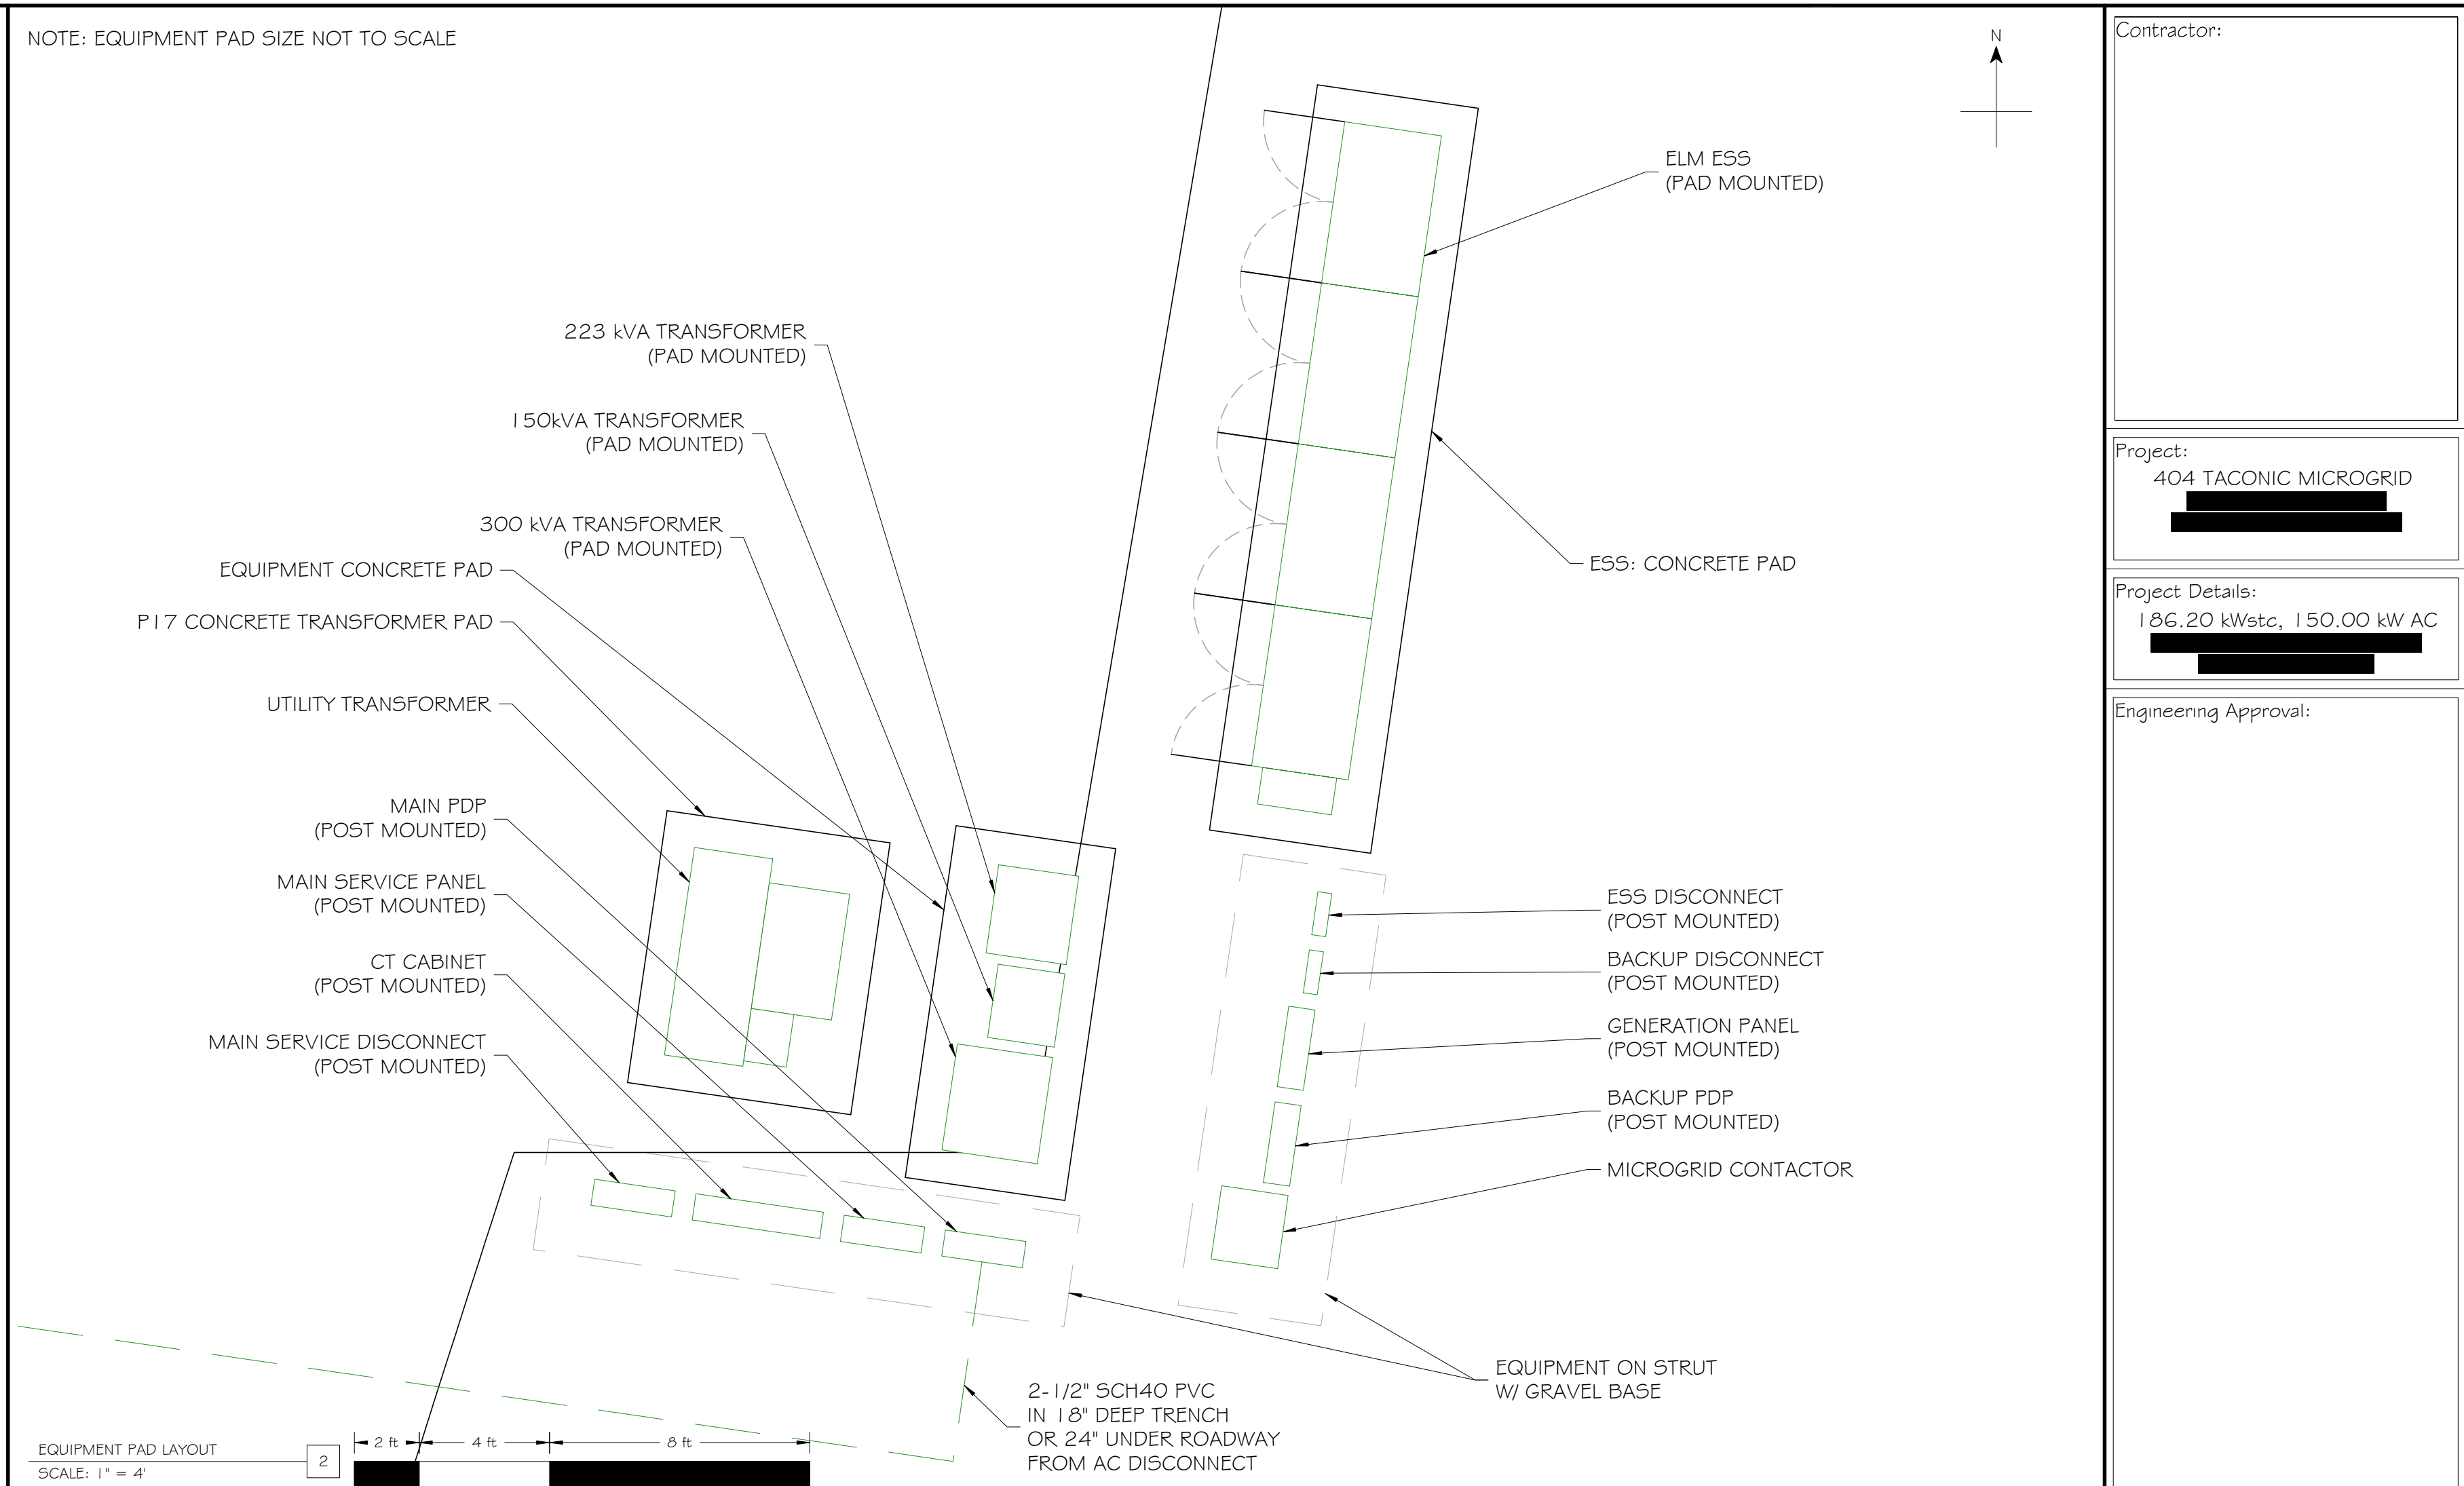

EQUIPMENT PAD LAYOUT
SCALE: 1" = 4'

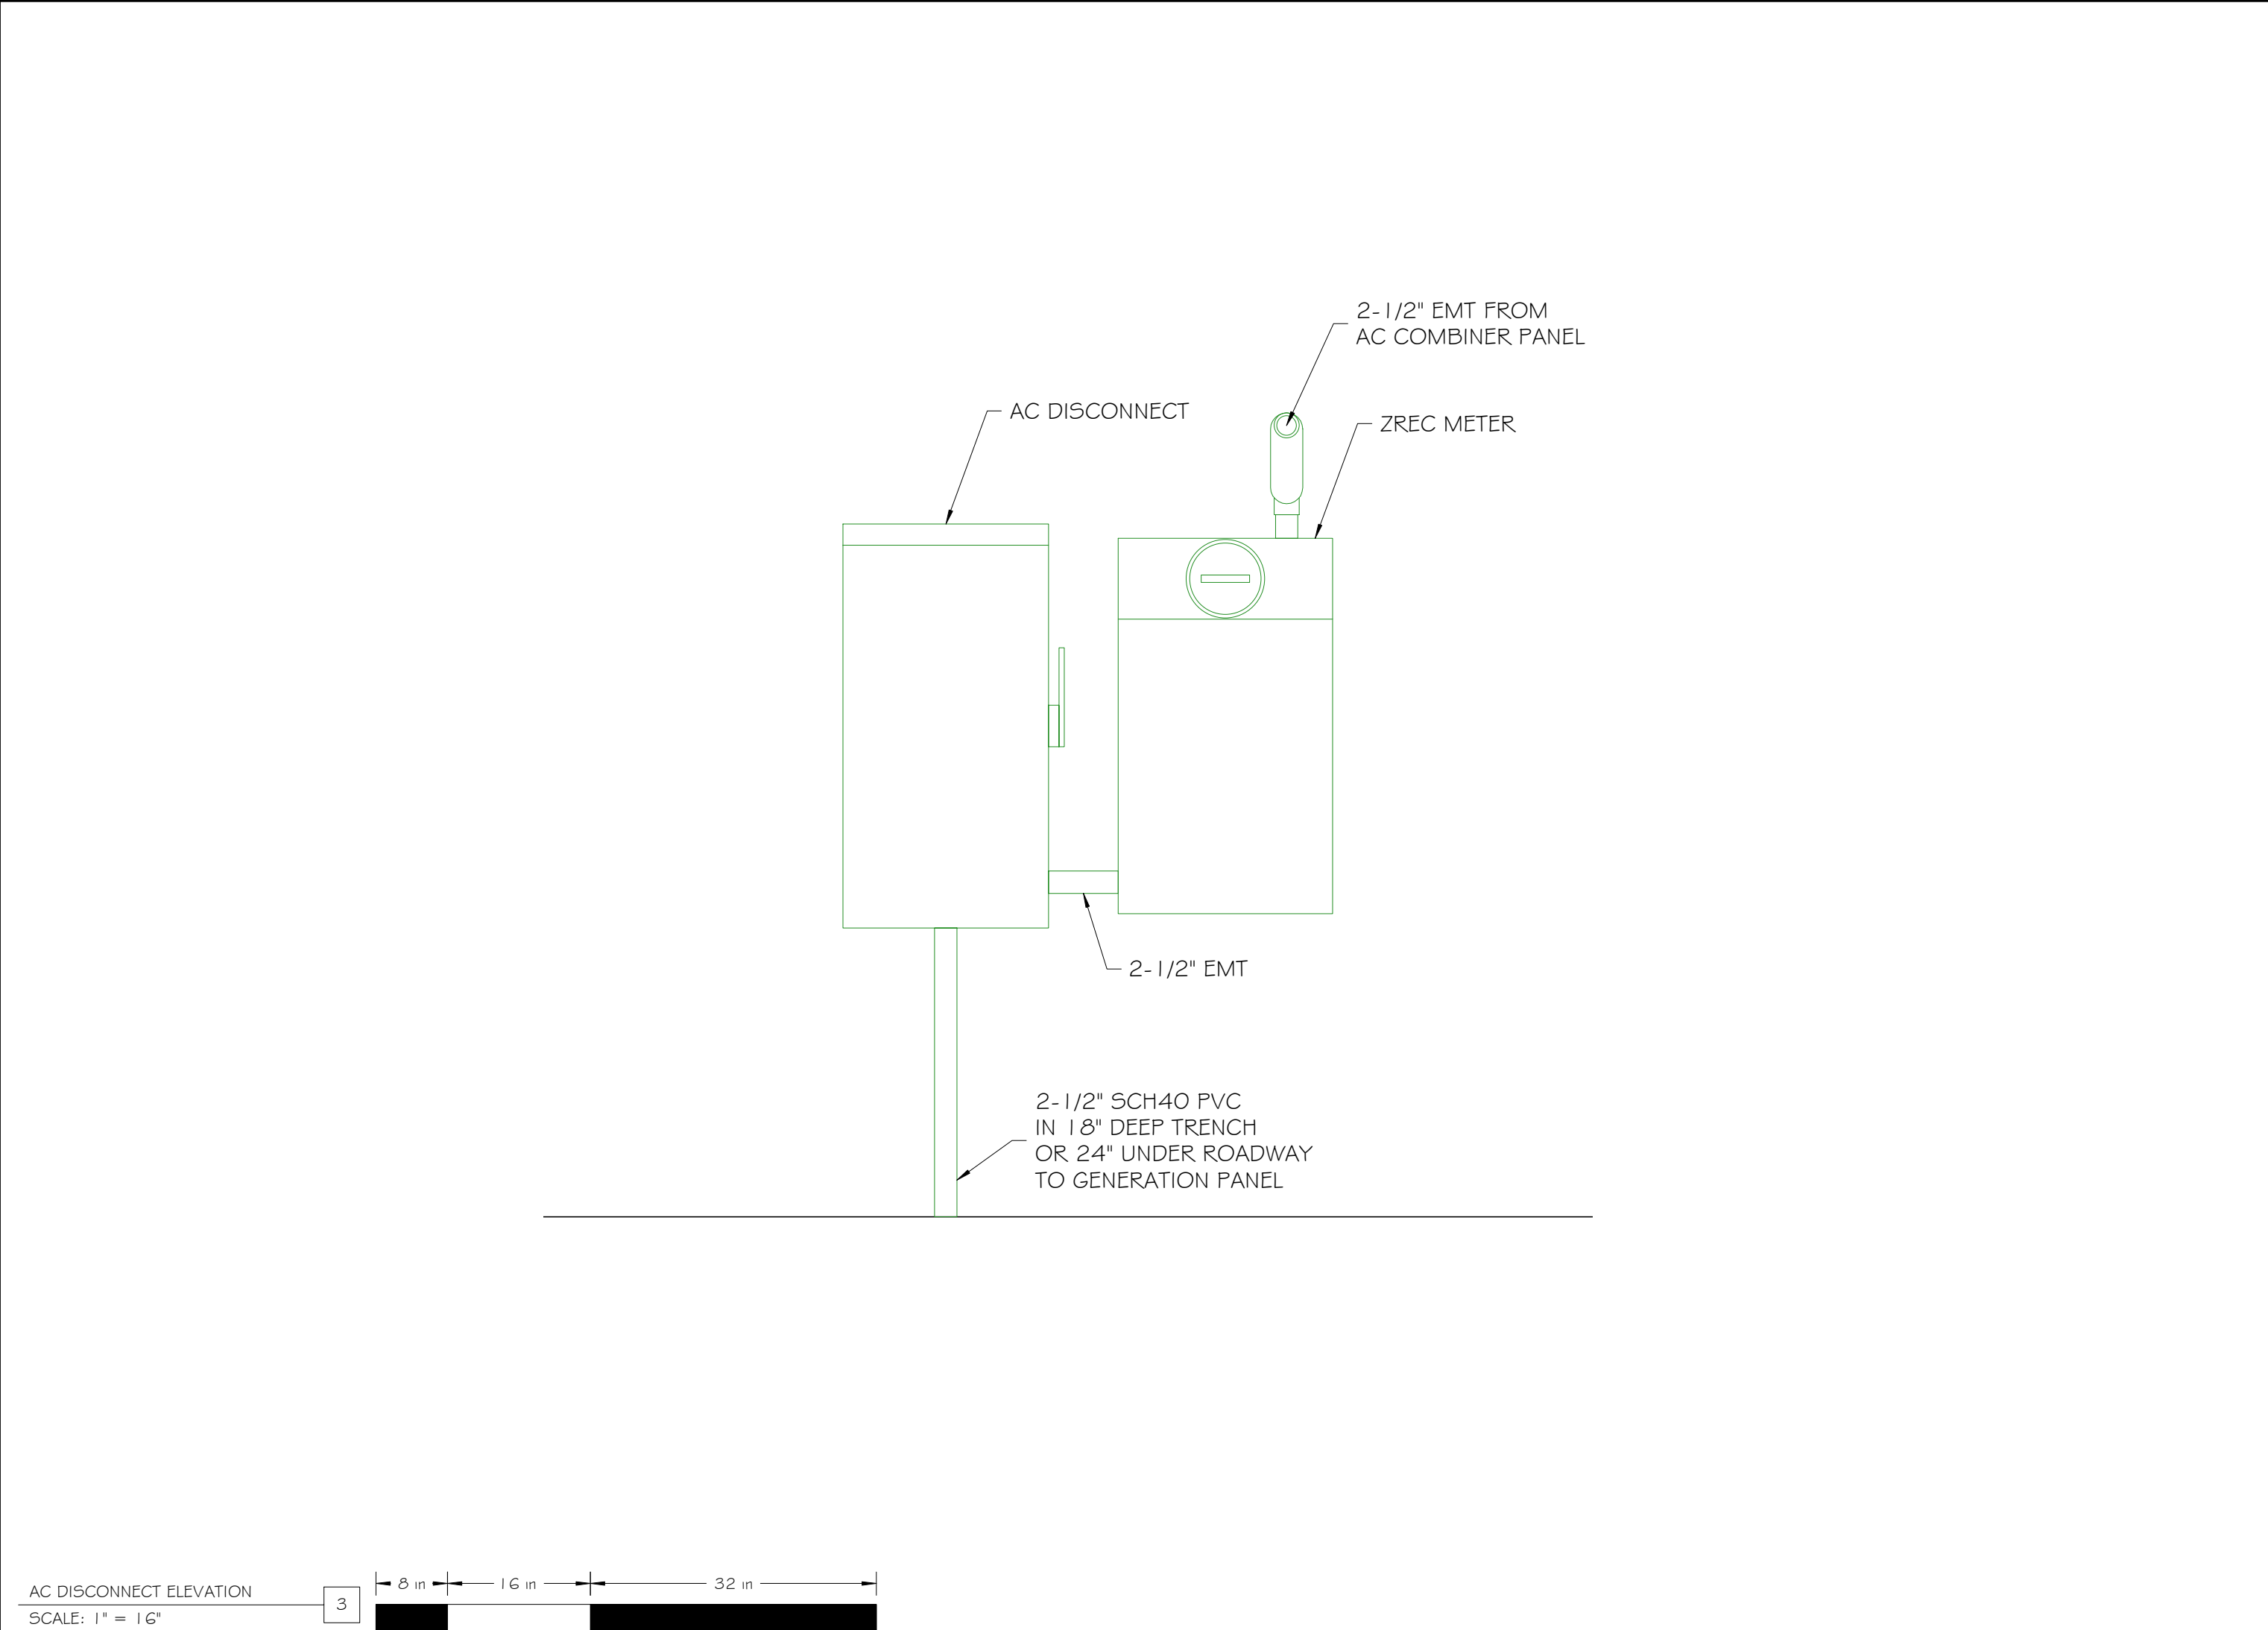

AC DISCONNECT ELEVATION
SCALE: 1" = 16"

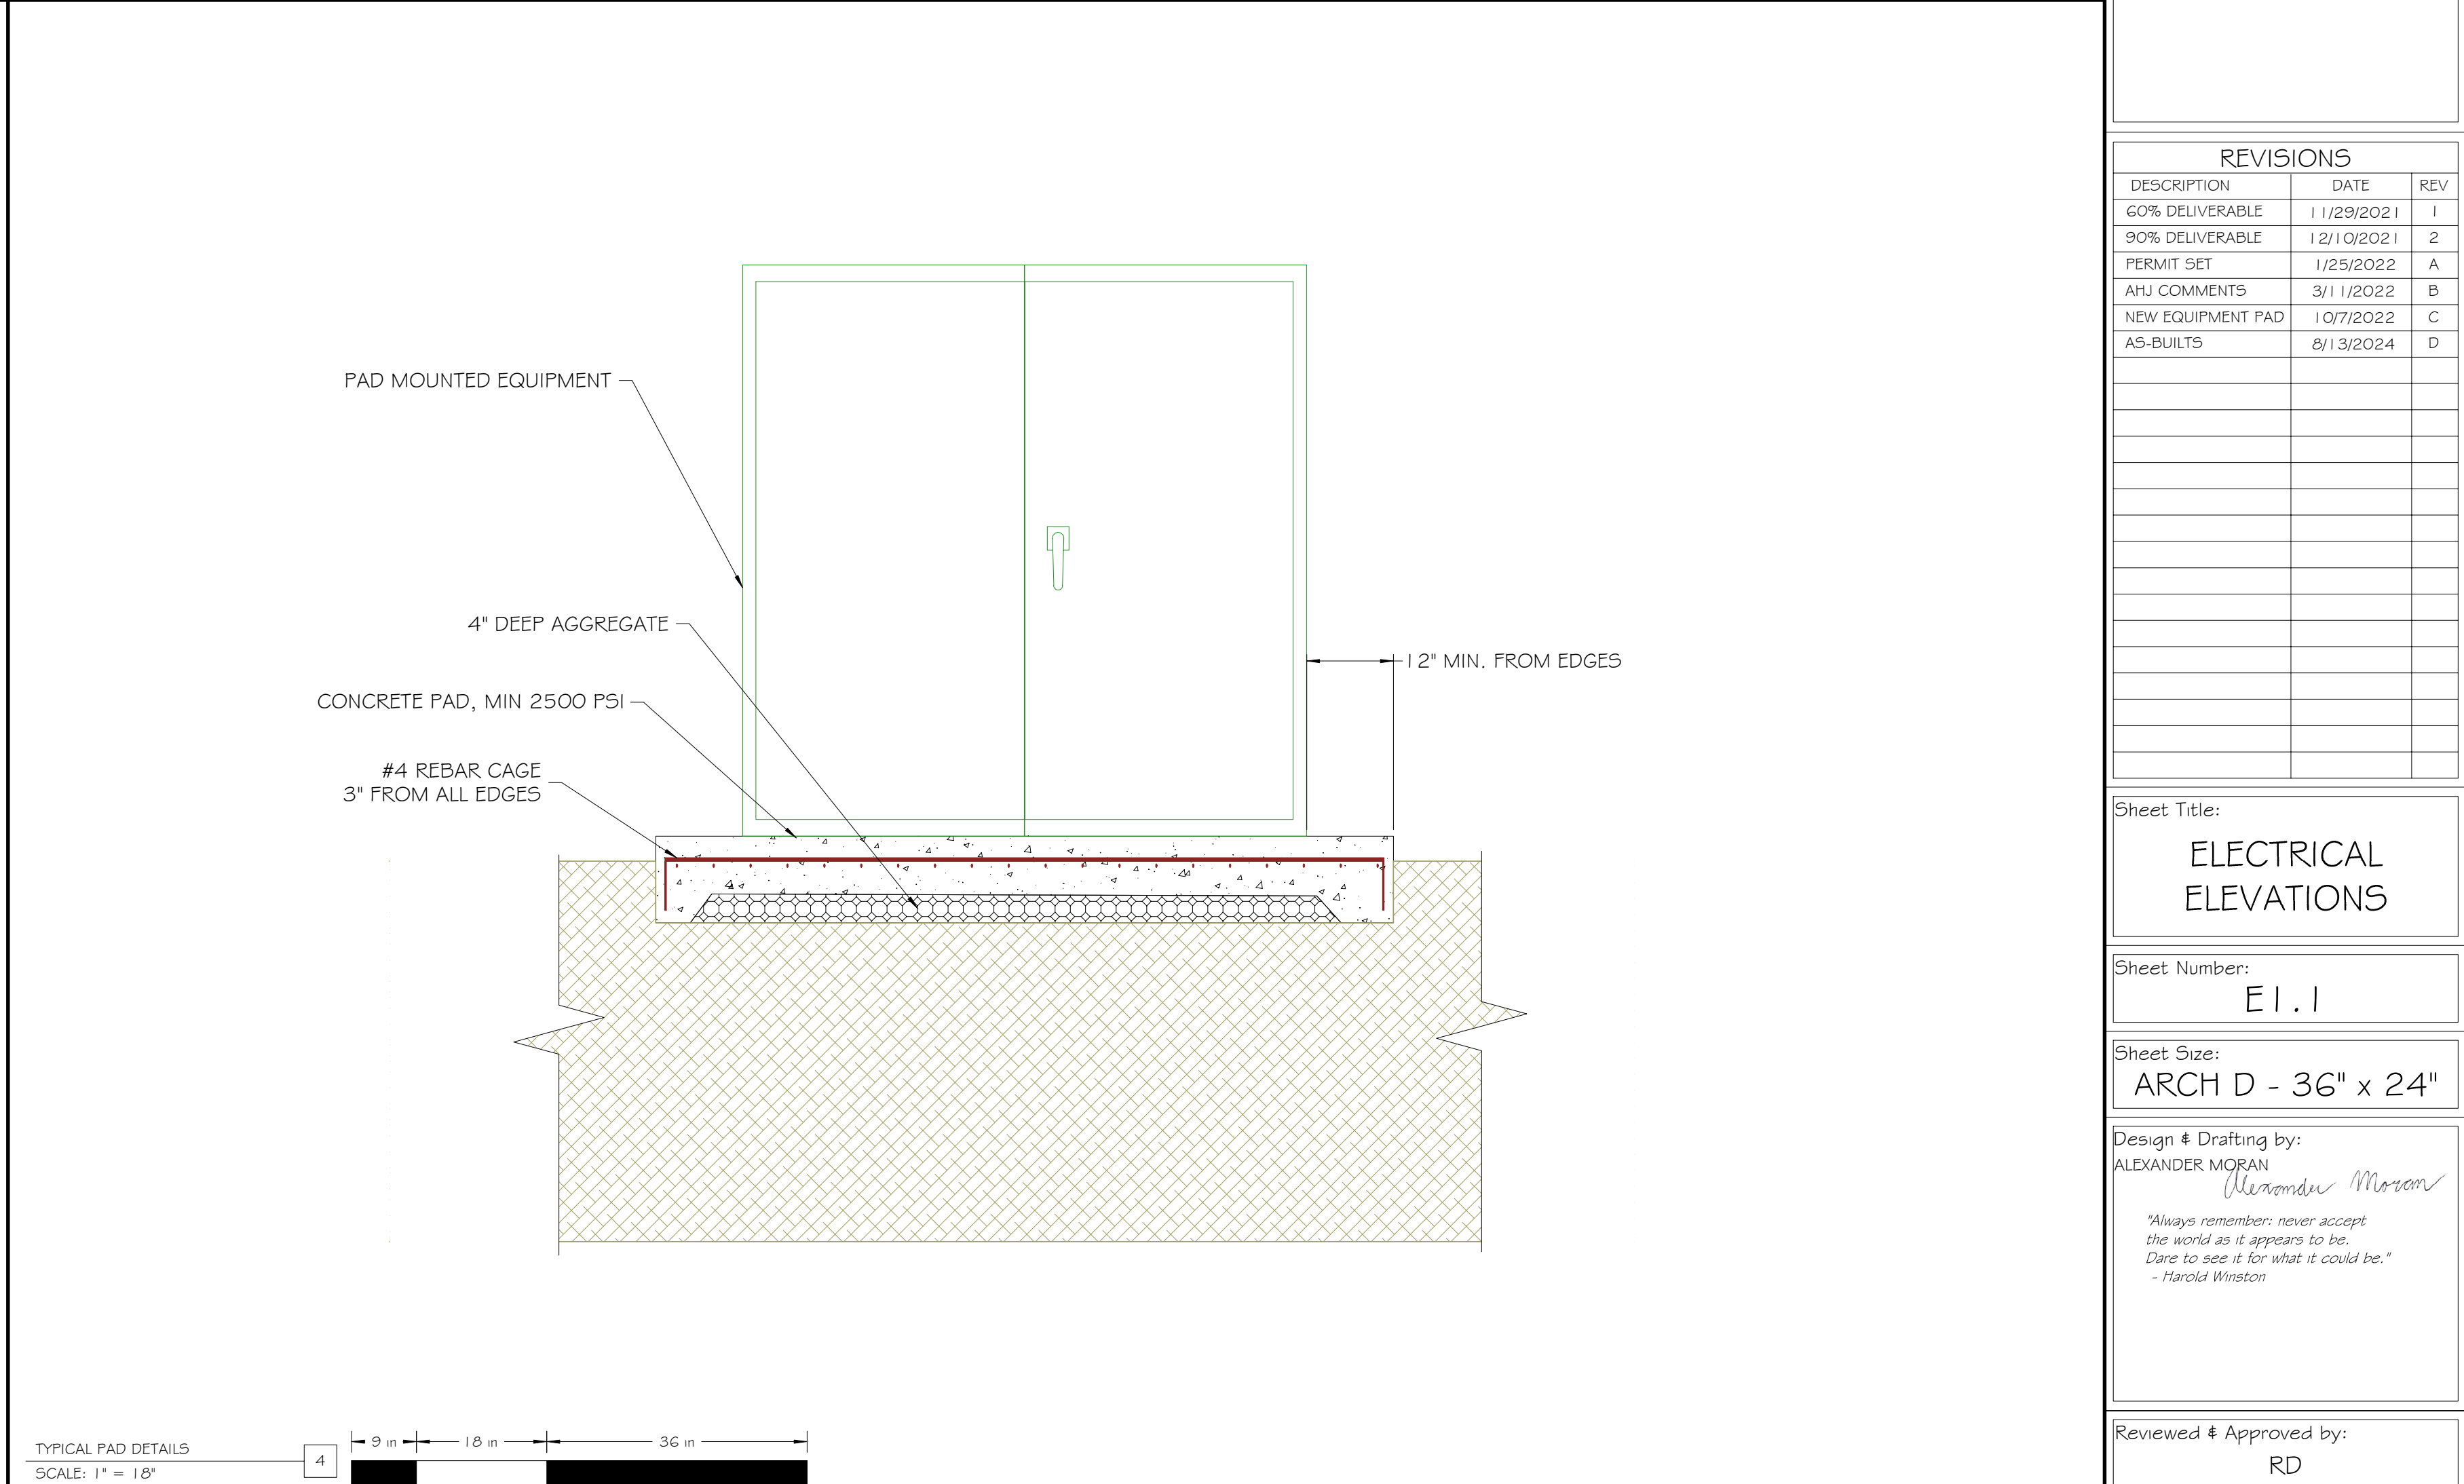

TYPICAL PAD DETAILS
SCALE: 1" = 18"

Contractor:

Project:
404 TACONIC MICROGRID

Project Details:
186.20 kWstc, 150.00 kW AC

Engineering Approval:

REVISIONS		
DESCRIPTION	DATE	REV
60% DELIVERABLE	11/29/2021	1
90% DELIVERABLE	12/10/2021	2
PERMIT SET	1/25/2022	A
AHJ COMMENTS	3/11/2022	B
NEW EQUIPMENT PAD	10/7/2022	C
AS-BUILTS	8/13/2024	D

Sheet Title:
ELECTRICAL ELEVATIONS


Sheet Number:
E1.1

Sheet Size:
ARCH D - 36" x 24"

Design & Drafting by:
ALEXANDER MORAN
Alexander Moran
"Always remember: never accept the world as it appears to be. Dare to see it for what it could be."
- Harold Winston


Reviewed & Approved by:
RD

CONDUIT NOTES:
 1.) CONDUIT STRAPS SHALL BE PLACED WITHIN 12" OF BENDS GREATER THAN 15°
 2.) ALL MATERIAL SHALL BE WEATHERPROOF AND LISTED FOR OUTDOOR INSTALLATION (WHERE REQUIRED).

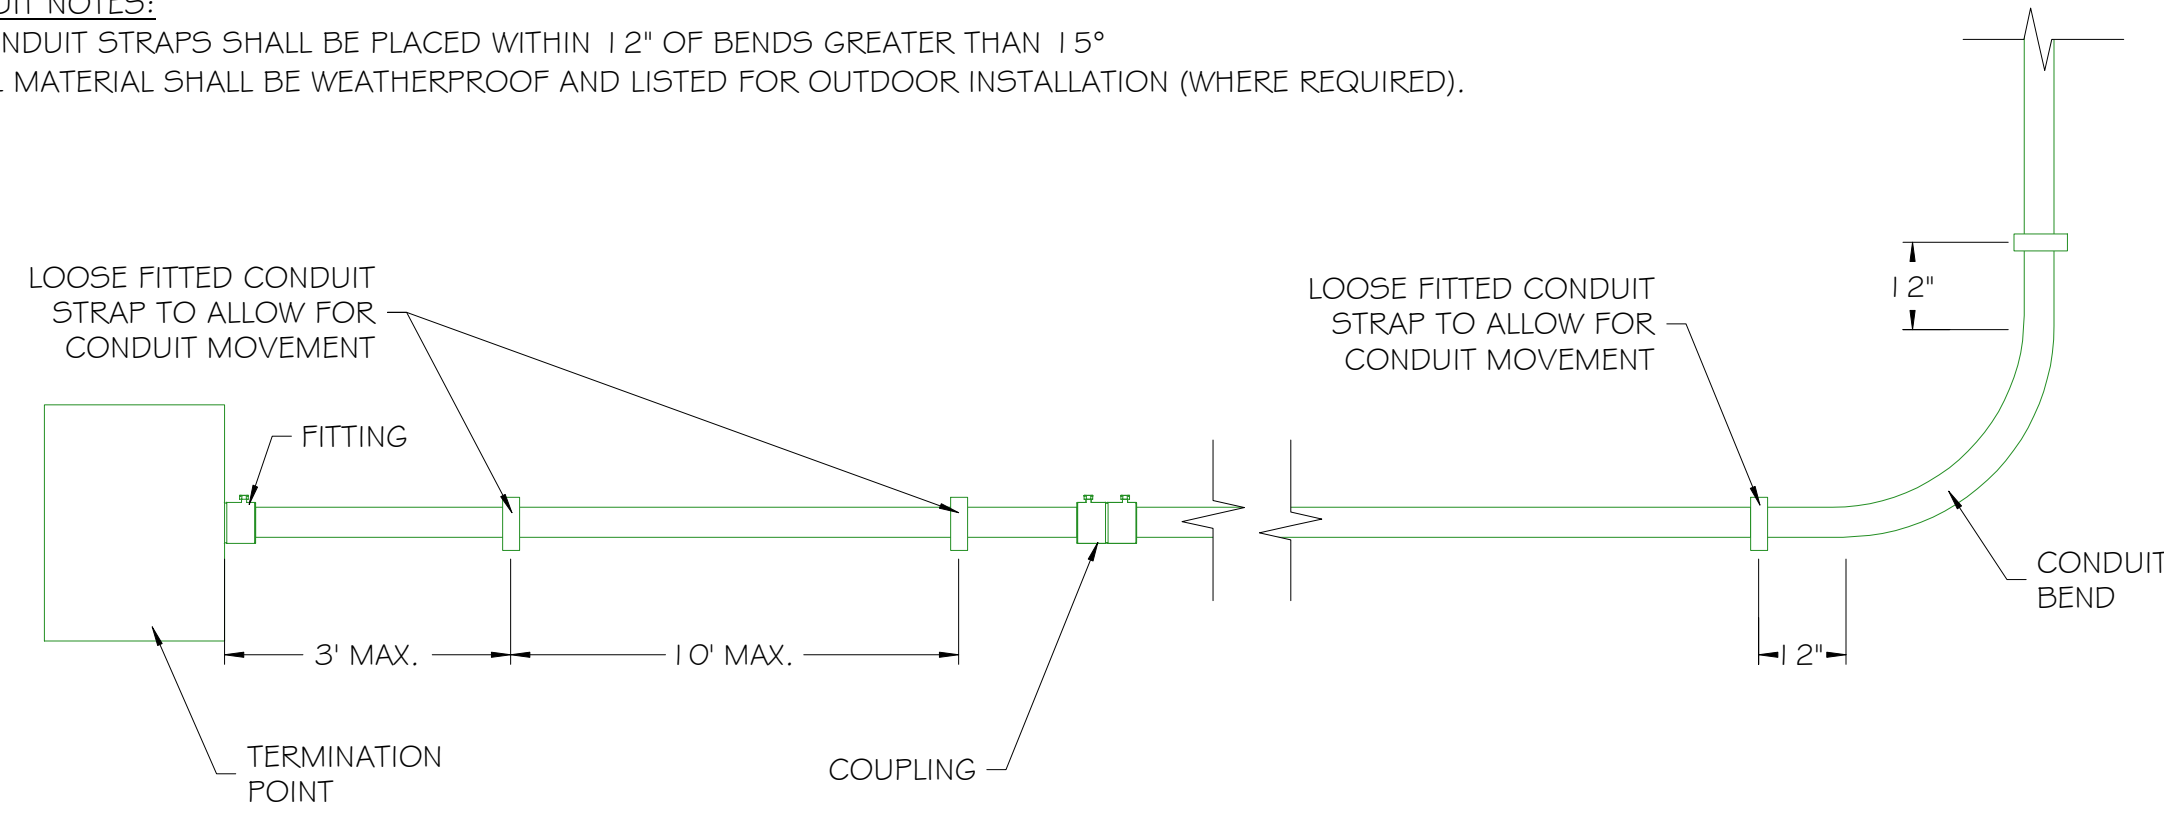


CONDUIT DETAIL
SCALE: NTS 1A

CONDUIT NOTES:
 1.) CONDUIT SHALL HAVE MIN. 1" CLEARANCE ABOVE ROOF SURFACE.
 2.) CONDUIT MOUNTING HEIGHT SPECIFIED IN CALCULATIONS ON ELECTRICAL DIAGRAM.
 3.) CONDUIT SUPPORTS SHALL BE PLACED WITHIN 12" OF BENDS GREATER THAN 15°
 4.) ALL MATERIAL SHALL BE WEATHERPROOF AND LISTED FOR OUTDOOR INSTALLATION (WHERE REQUIRED).

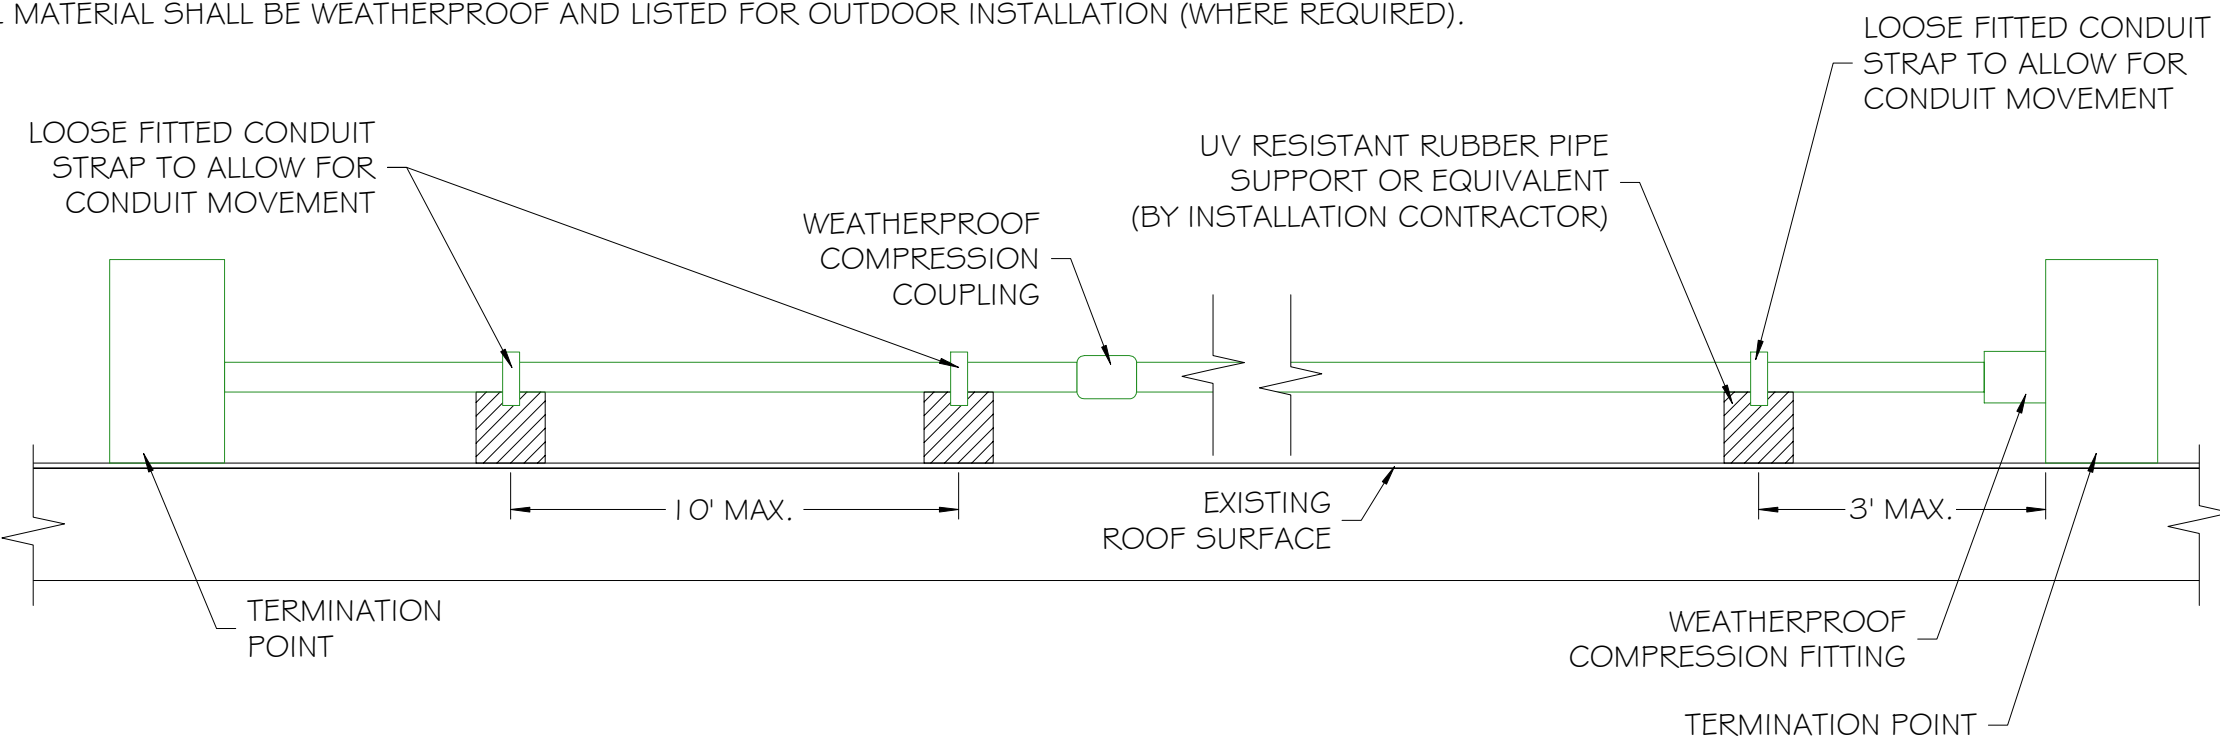


CONDUIT DETAIL
SCALE: NTS 1B

NOTES:
 1.) BACKFILL WITH NATIVE MATERIAL IN COMPLIANCE WITH NEC 300.5(F). NATIVE MATERIAL SHALL BE APPROVED BY THE OWNERS REP. PRIOR TO USE. IF NOT ACCEPTABLE, USE FINE GRANULAR MATERIAL FOR BEDDING AND SIDE/TOP COVER.
 2.) ASPHALT TO BE SAWCUT PRIOR TO TRENCHING. PAVEMENT SHALL BE REPLACED IN KIND.
 3.) UNPAVED SURFACES SHALL BE RESTORED IN KIND TO MATCH EXISTING CONDITIONS.
 4.) DETECTABLE WARNING TAPE SHALL BE INSTALLED 12" BELOW GRADE.
 5.) REFER TO ELECTRICAL DRAWINGS FOR SIZE AND TYPE OF CONDUIT.
 6.) NOTIFY UTILITY COMPANY PRIOR TO DIGGING PER "DIG SAFE" REQUIREMENTS.

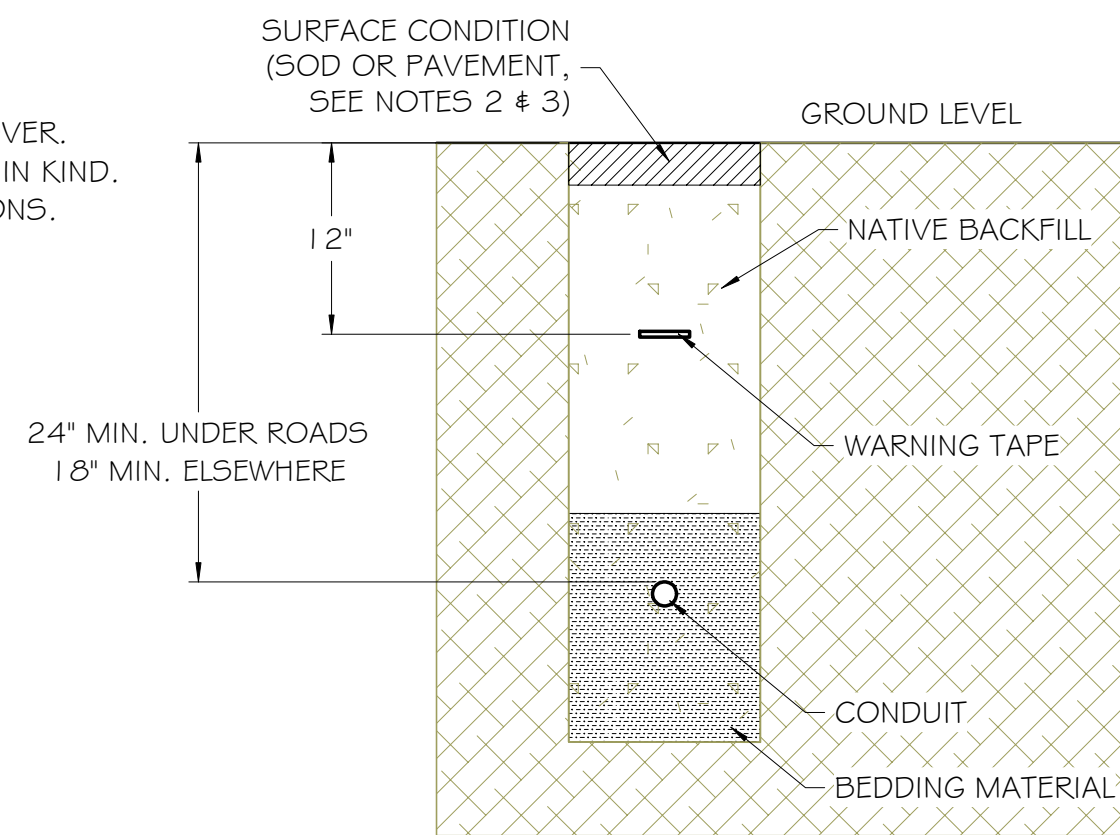


TRENCH CROSS-SECTION
SCALE: NTS 5

NOTES:
 1.) CONDUIT SHALL BE INSTALLED WHERE 1000V CONDUCTORS ARE RAN IN AN ACCESSIBLE LOCATION.
 2.) WHERE EXPOSED TO PHYSICAL DAMAGE, SCH40 PVC SHALL TRANSITION TO AN APPROVED METALLIC CONDUIT OR SCH80 PVC WITHIN A REASONABLE DISTANCE FROM WHERE THE CONDUIT EXITS THE EARTH.
 3.) SCH80 PVC IS PERMITTED WHERE EXPOSED TO PHYSICAL DAMAGE.

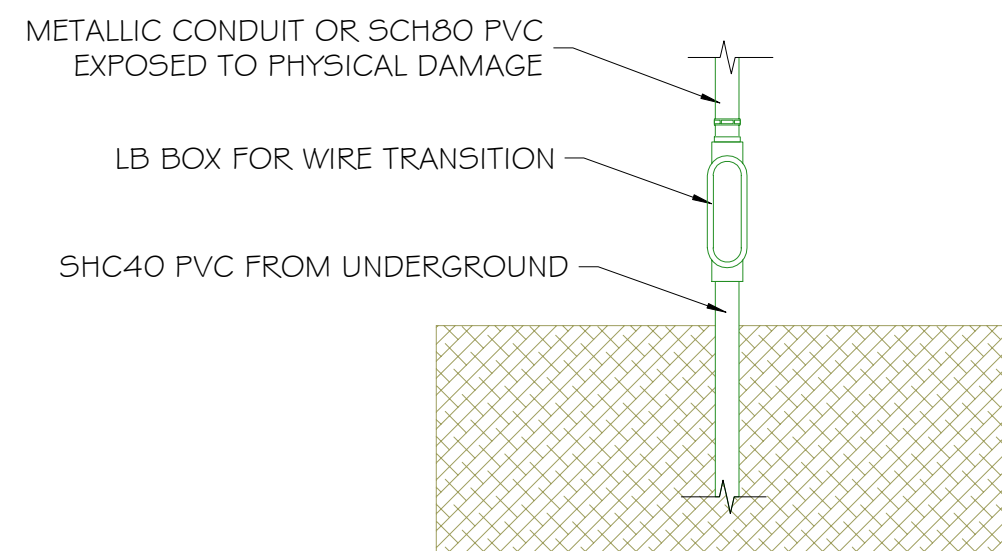


CONDUIT BODY TRANSITION
SCALE: NTS 7B

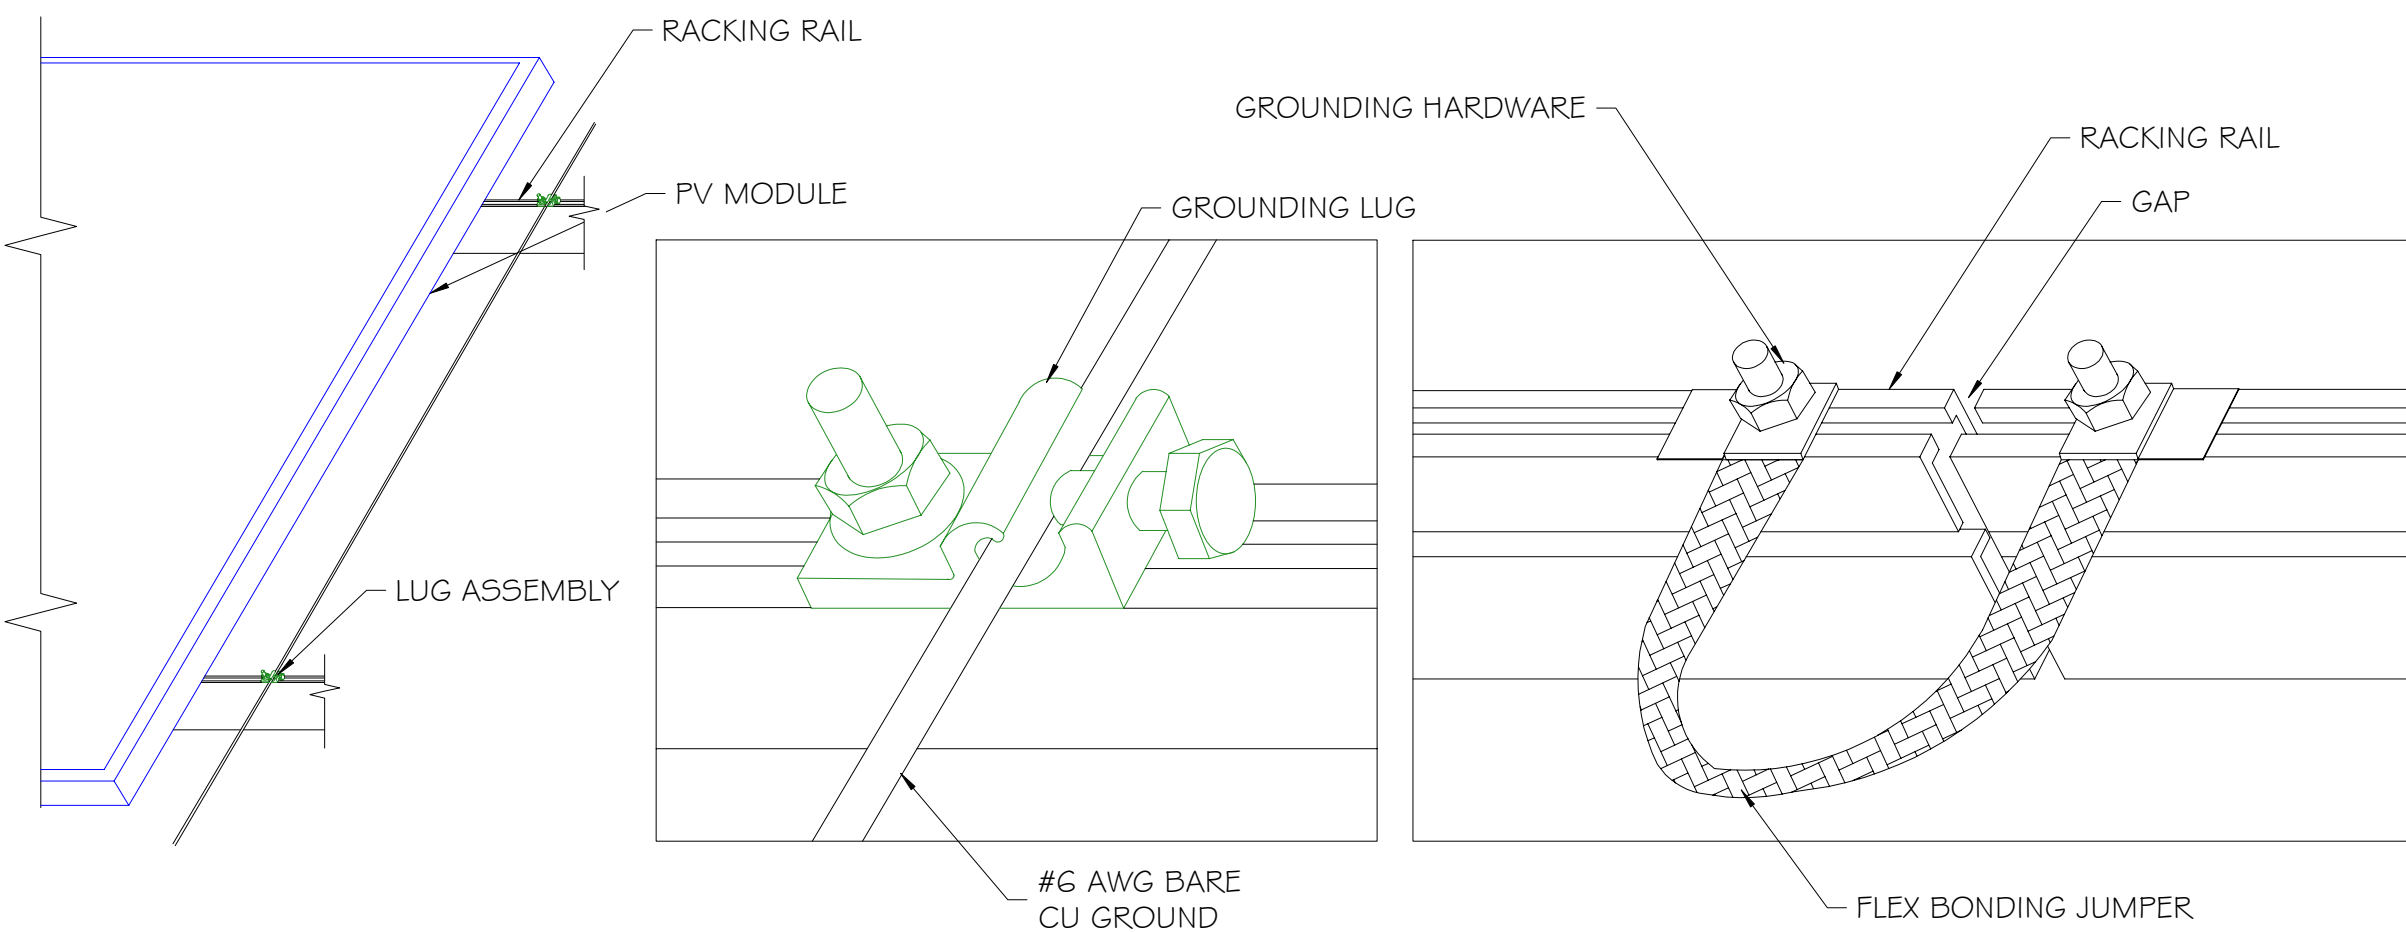


RACKING GROUNDING
SCALE: NTS 9

NOTE:
 1.) RSD UNIT SHALL PROVIDE MODULE-LEVEL RAPID SHUTDOWN FUNCTIONALITY PER NEC 690.12 WHEN INSTALLED PER MANUFACTURER INSTRUCTIONS.
 2.) DEVICE SHALL BE CONTROLLED BY MANUFACTURER-APPROVED METHODS.

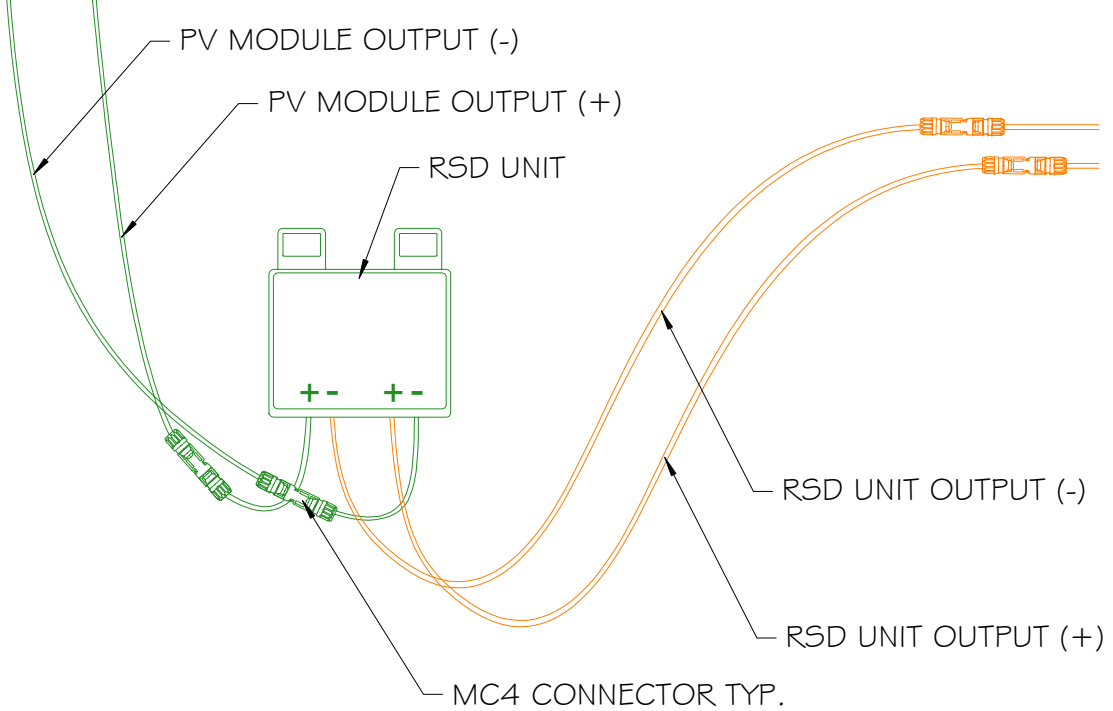

RSD DETAIL
SCALE: NTS 10

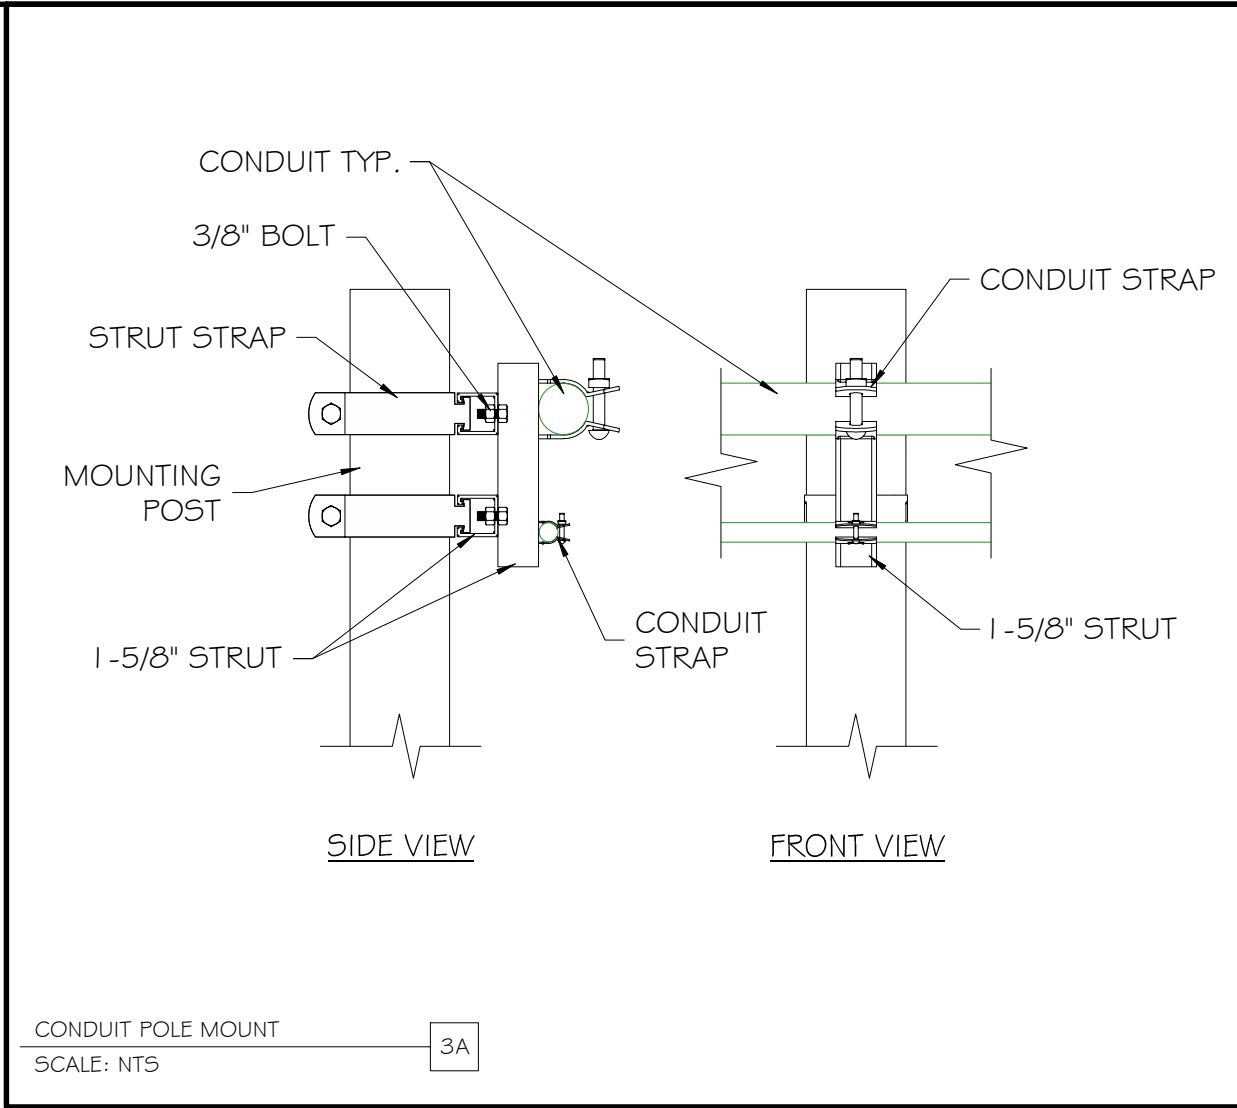

CONDUIT POLE MOUNT
SCALE: NTS 3A

Contractor:

Project:
404 TACONIC MICROGRID

Project Details:
186.20 kWstc, 150.00 kW AC

Engineering Approval:

REVISIONS

DESCRIPTION	DATE	REV
60% DELIVERABLE	11/29/2021	1
90% DELIVERABLE	12/10/2021	2
PERMIT SET	1/25/2022	A
AHJ COMMENTS	3/11/2022	B
NEW EQUIPMENT PAD	10/7/2022	C
AS-BUILTS	8/13/2024	D

Sheet Title:

**CONSTRUCTION
DETAILS**

Sheet Number:

E1.2

Sheet Size:






 

ARCH D - 36" x 24"

Design & Drafting by:

Alexander Moran
Alexander Moran
 "Always remember: never accept the world as it appears to be. Dare to see it for what it could be."
 - Harold Winston

Reviewed & Approved by:

RD

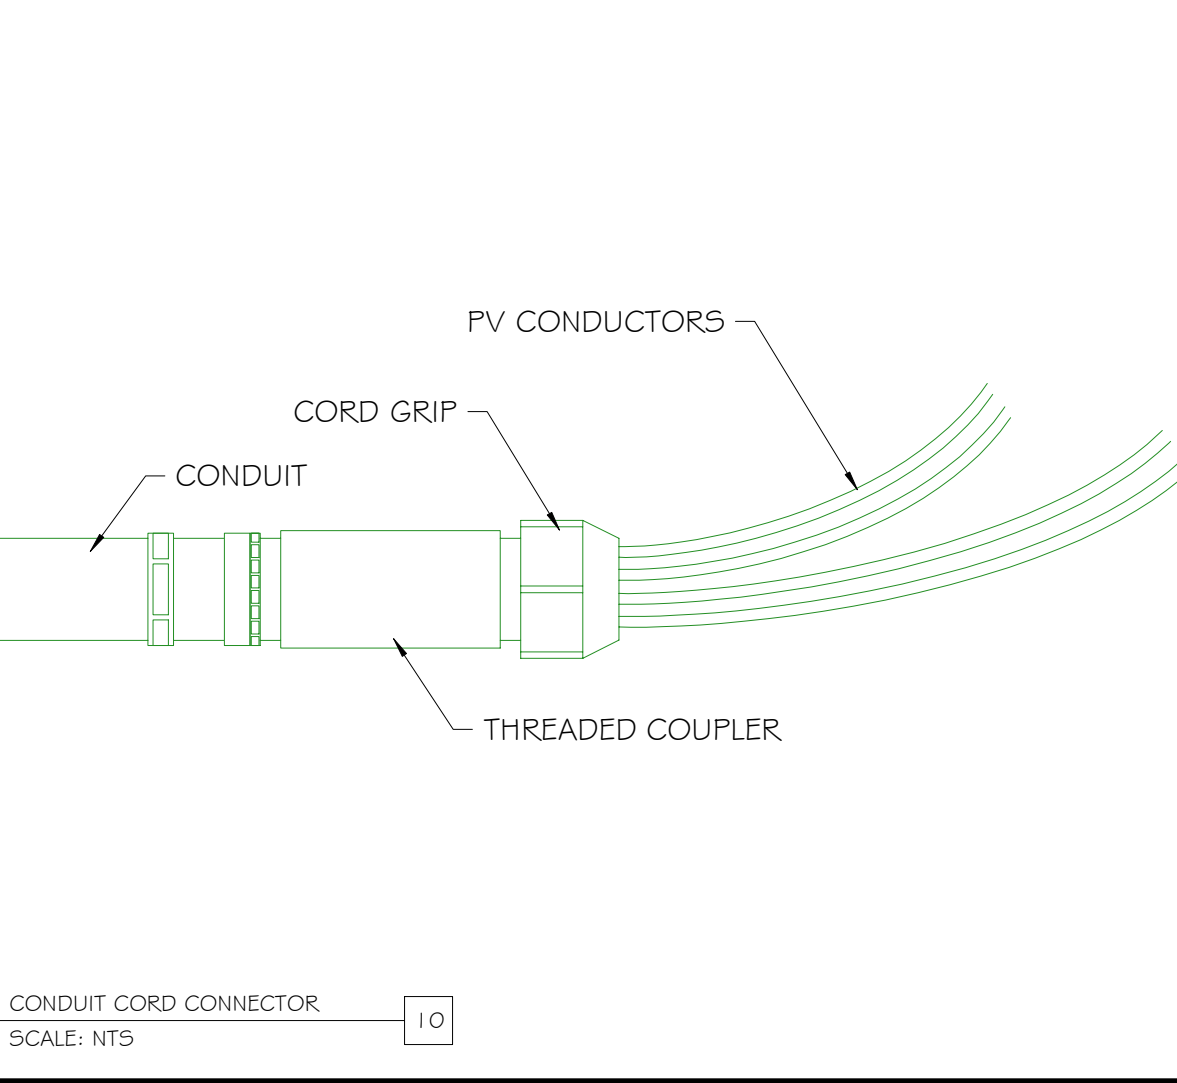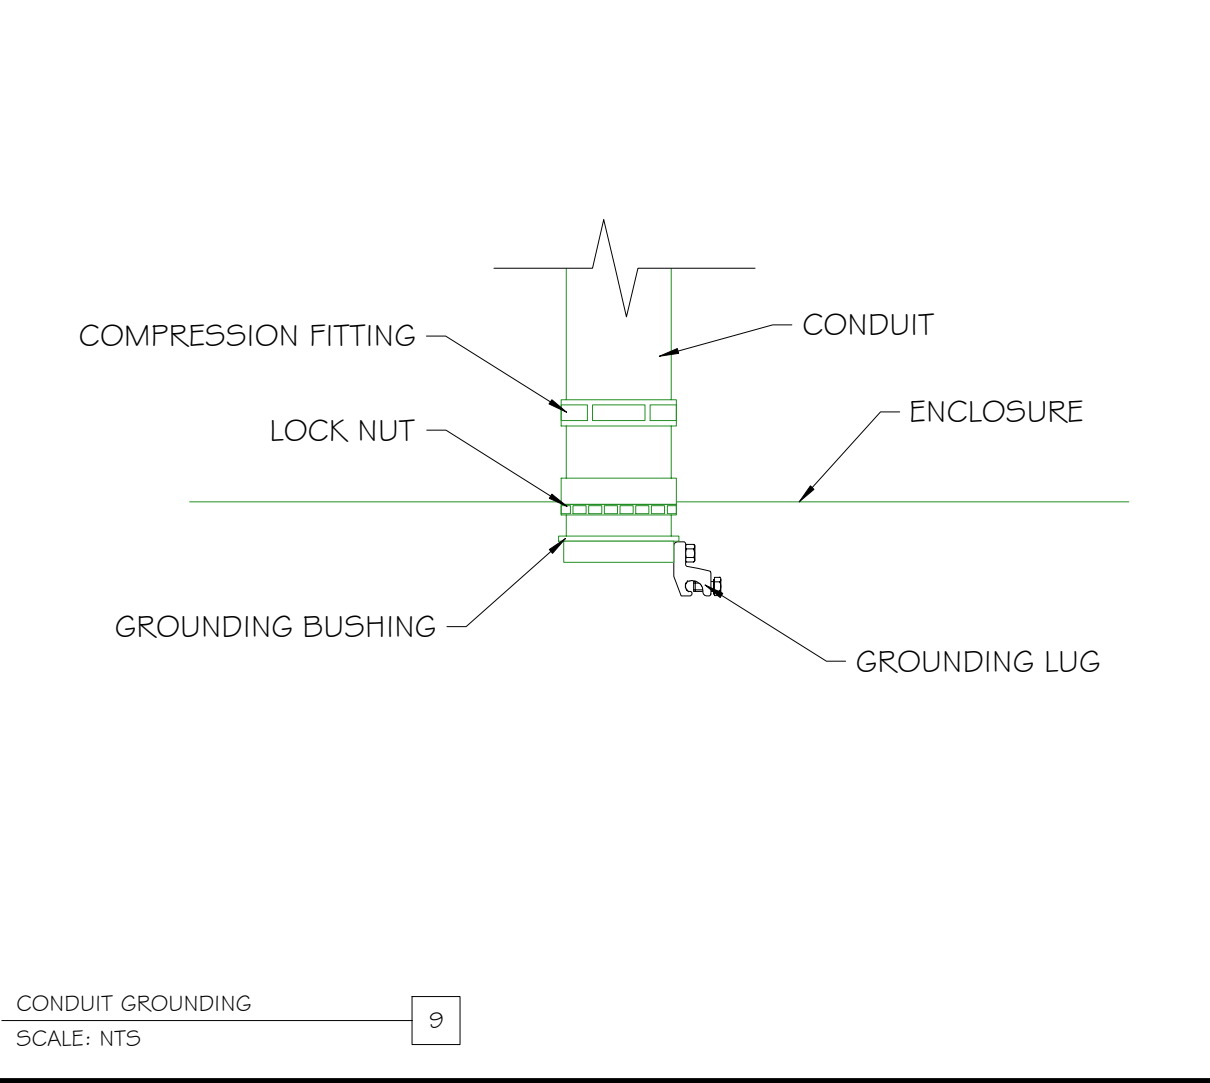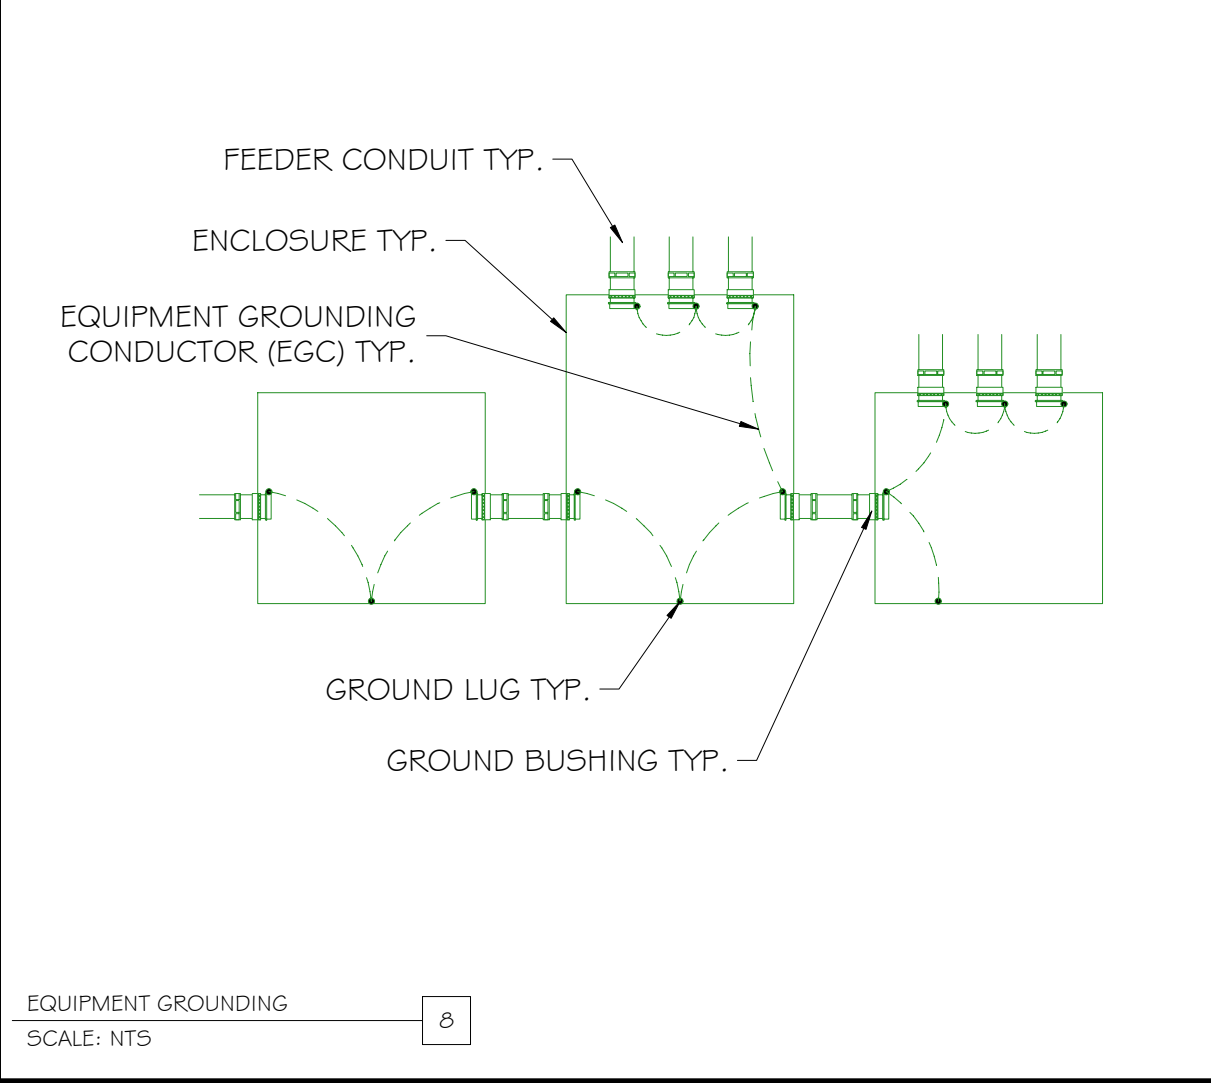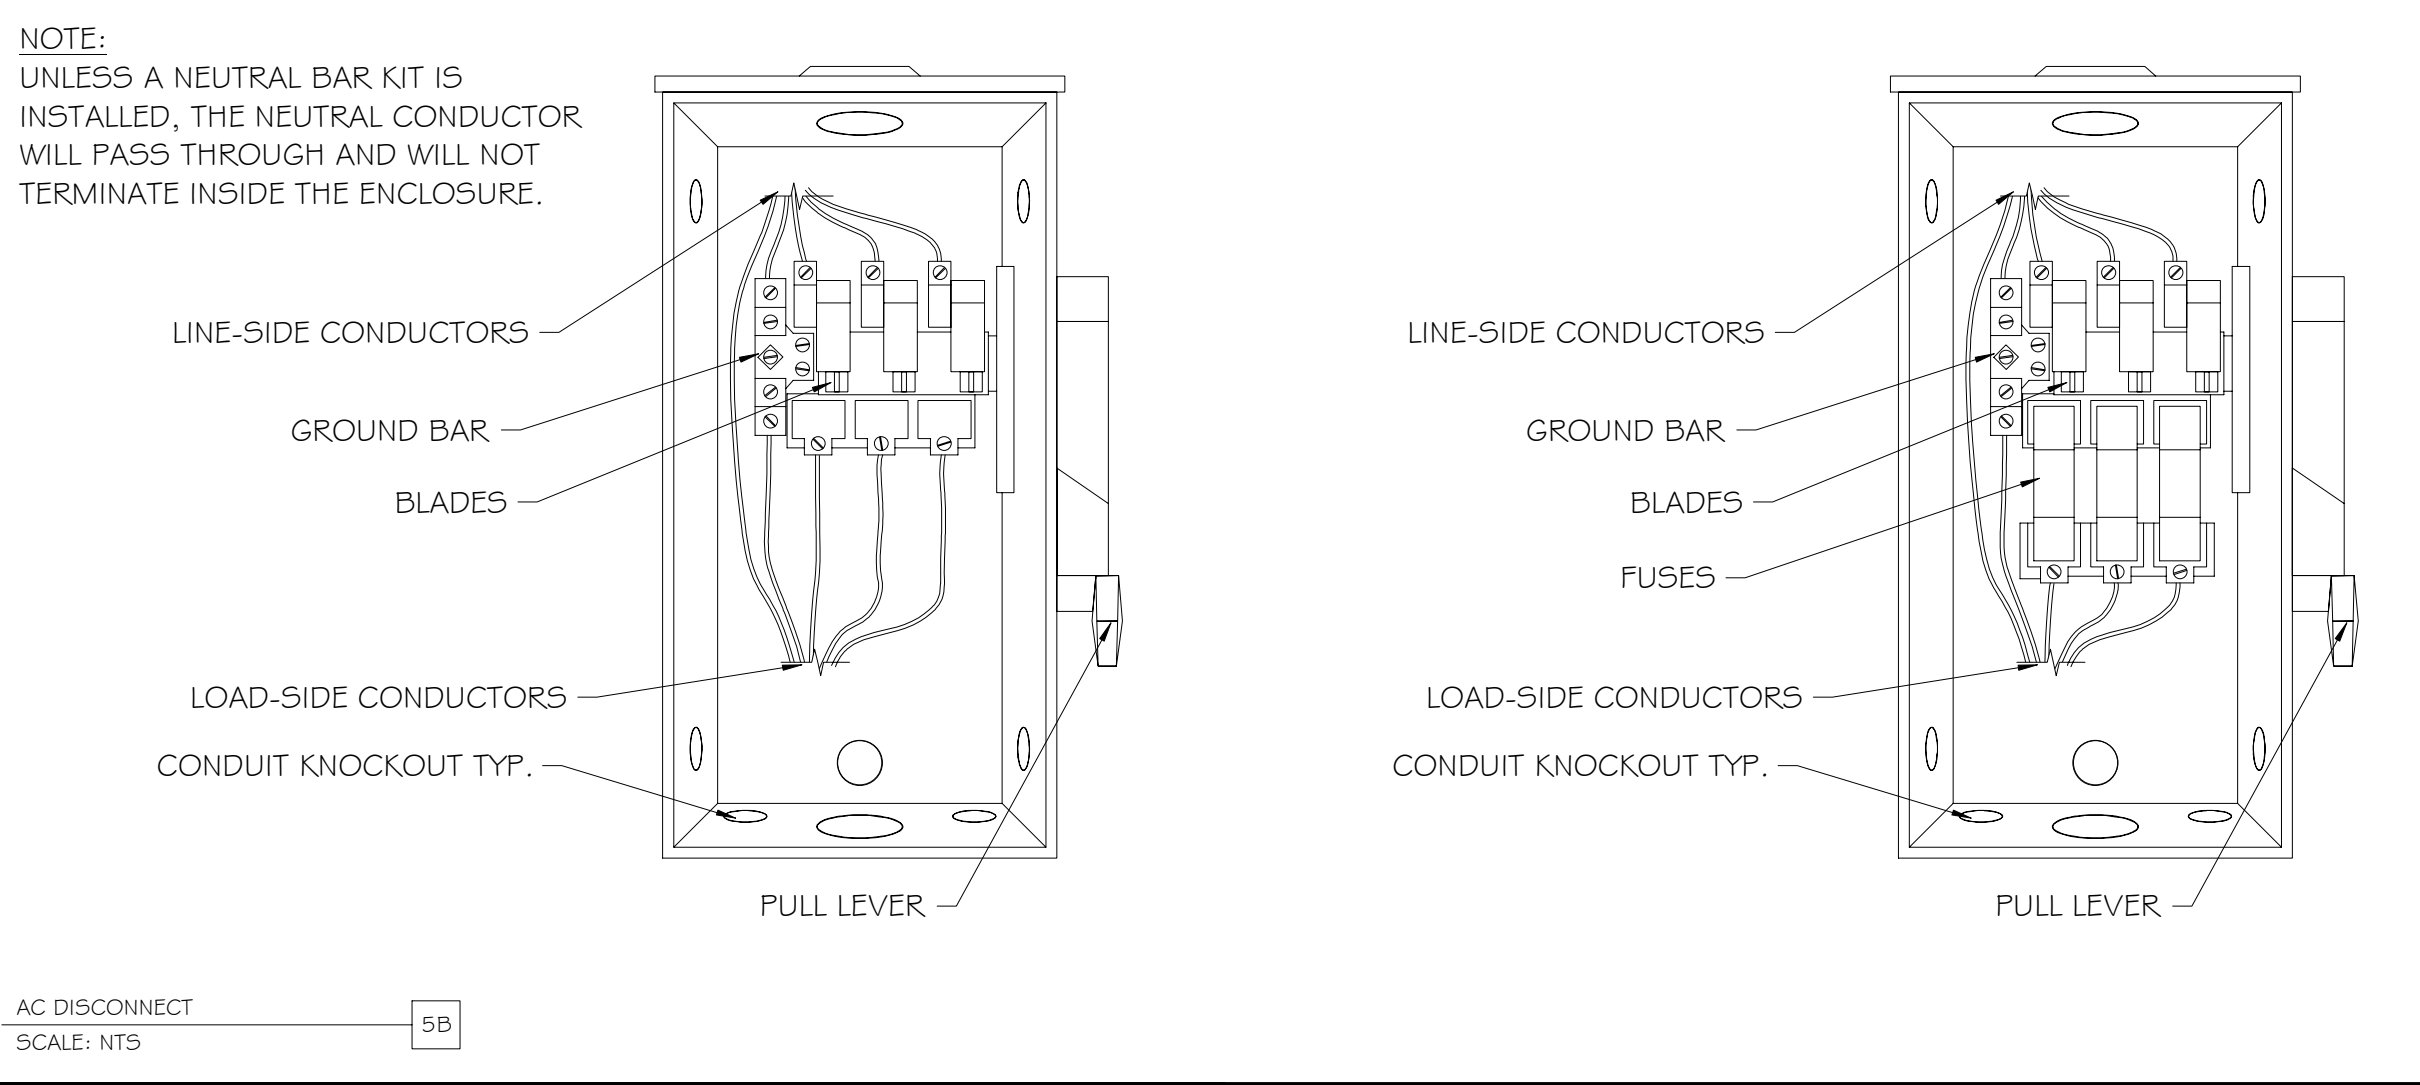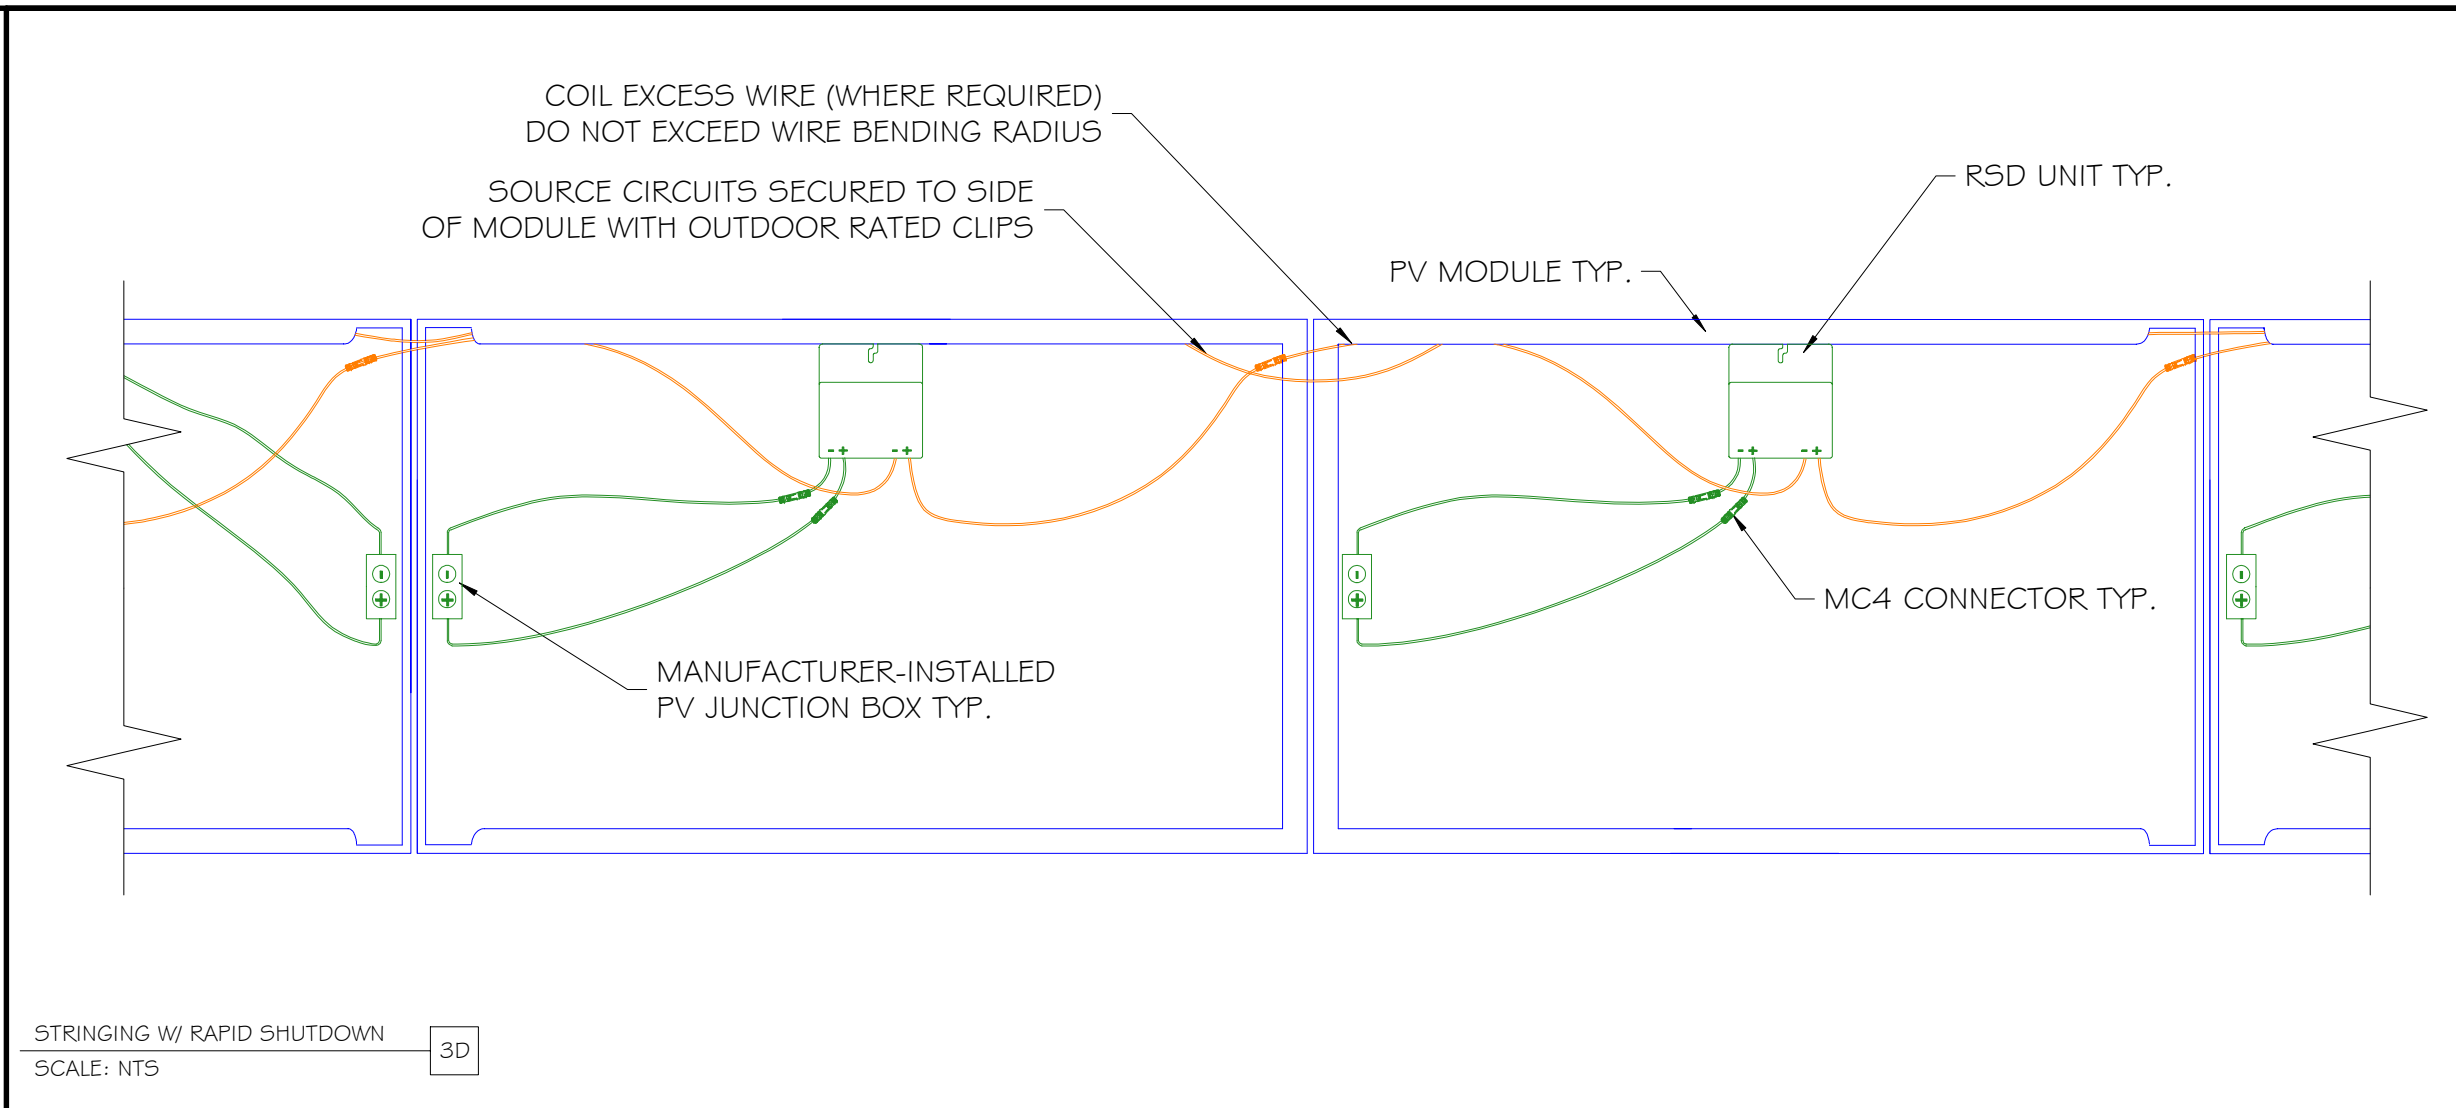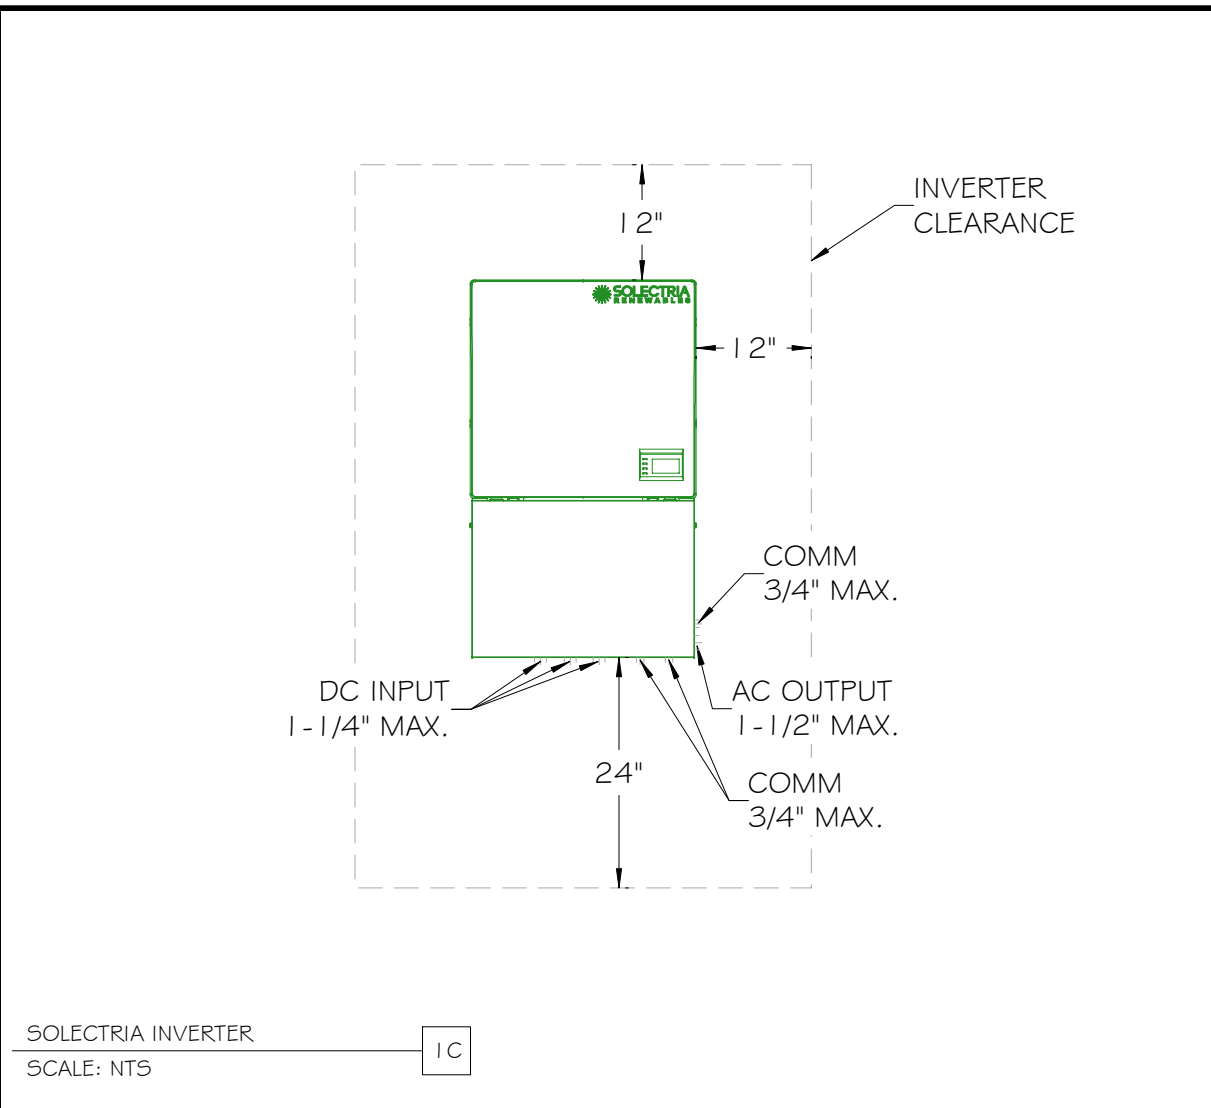

Contractor:

Project:
404 TACONIC MICROGRID

Project Details:
186.20 kWstc, 150.00 kW AC

Engineering Approval:

REVISIONS		
DESCRIPTION	DATE	REV
60% DELIVERABLE	11/29/2021	1
90% DELIVERABLE	12/10/2021	2
PERMIT SET	1/25/2022	A
AHJ COMMENTS	3/11/2022	B
NEW EQUIPMENT PAD	10/7/2022	C
AS-BUILTS	8/13/2024	D

Sheet Title:
CONSTRUCTION DETAILS

Sheet Number:
E1.3

Sheet Size:
ARCH D - 36" x 24"

Design & Drafting by:
ALEXANDER MORAN
Alexander Moran

"Always remember: never accept the world as it appears to be. Dare to see it for what it could be."
- Harold Winston

Reviewed & Approved by:
RD


480V	---- = EQUIP. GROUNDING CONDUCTOR	— = CIRCUIT CONDUCTOR	= FUSE	= CIRCUIT BREAKER	(N) = NEW EQUIP.	(E) = EXISTING EQUIP.	L1 = LINE 1 (BROWN)	L2 = LINE 2 (ORANGE)	L3 = LINE 3 (YELLOW)	N = NEUTRAL (WHITE)	G = GROUND (GREEN)	⊕ = POSITIVE (RED)	⊖ = NEGATIVE (BLACK)
208V	---- = EQUIP. GROUNDING CONDUCTOR	— = CIRCUIT CONDUCTOR	= FUSE	= CIRCUIT BREAKER	(N) = NEW EQUIP.	(E) = EXISTING EQUIP.	L1 = LINE 1 (BLACK)	L2 = LINE 2 (RED)	L3 = LINE 3 (BLUE)	N = NEUTRAL (WHITE)	G = GROUND (GREEN)	⊕ = POSITIVE (RED)	⊖ = NEGATIVE (BLACK)

Contractor:

Project:
404 TACONIC MICROGRID

Project Details:
186.20 kWstc, 150.00 kW AC

Engineering Approval:

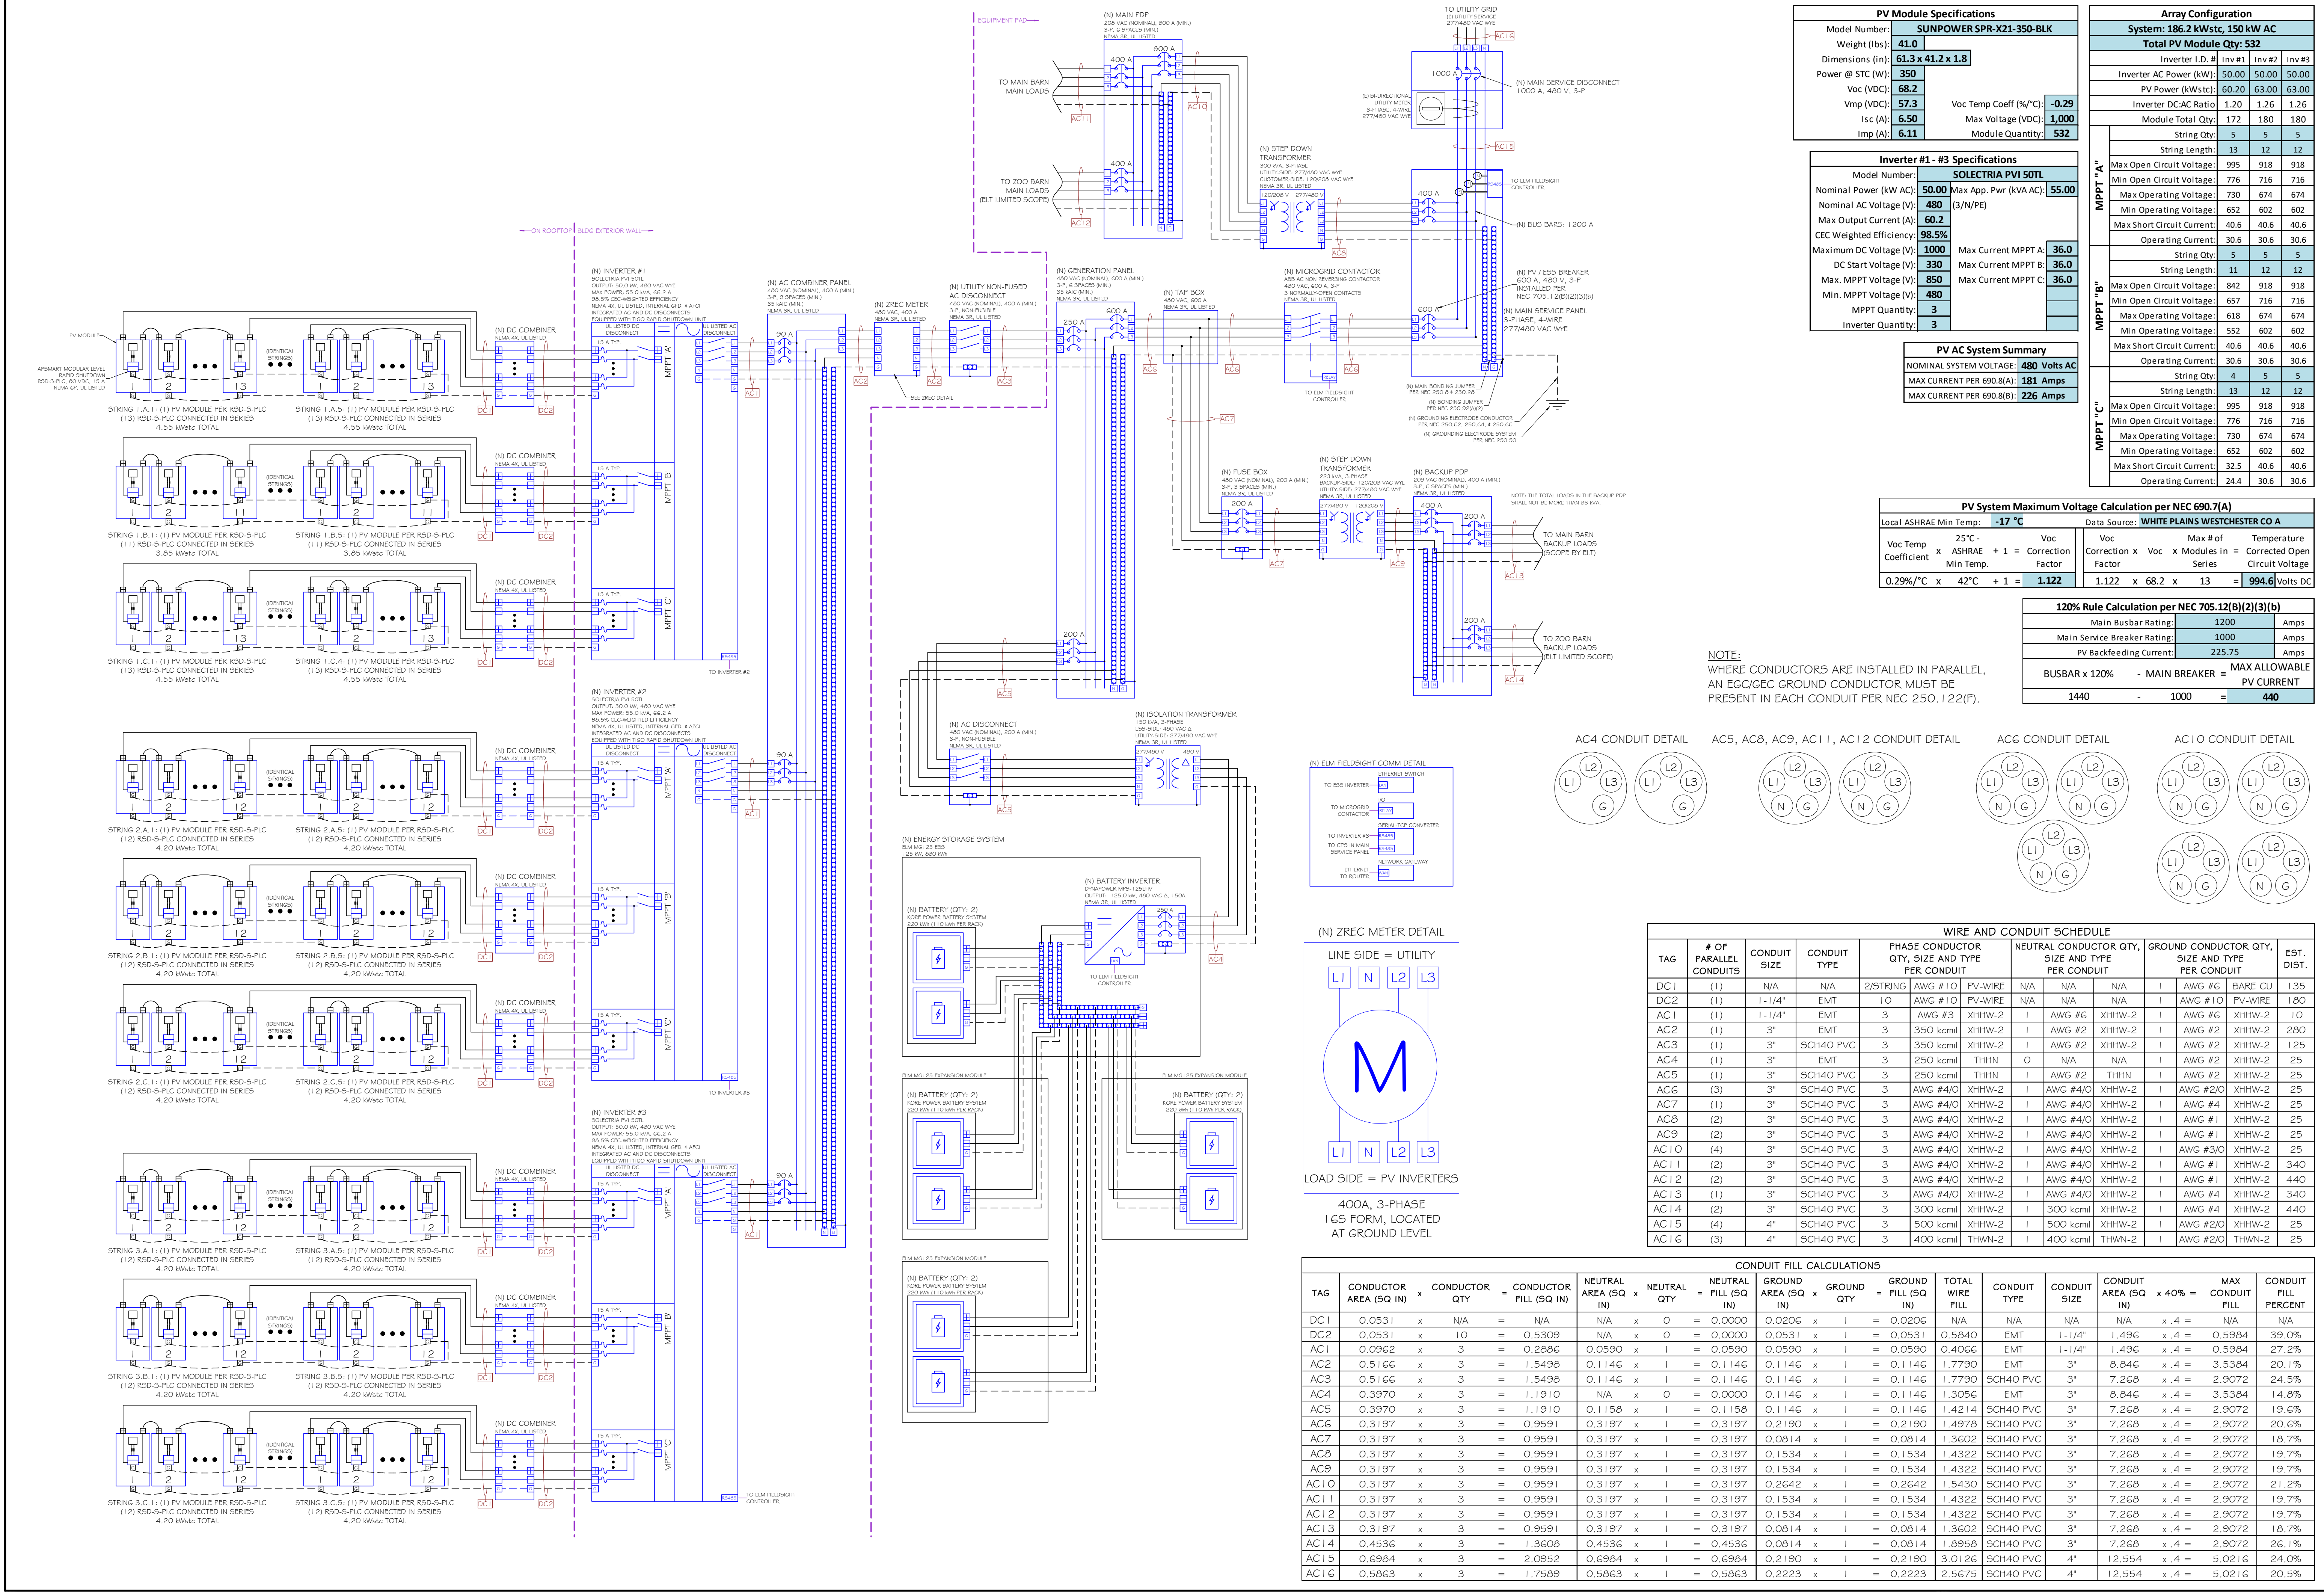

PV Module Specifications

Model Number:	SUNPOWER SPR-X21-350-BLK
Weight (lbs):	41.0
Dimensions (in):	61.3 x 41.2 x 1.8
Power @ STC (W):	350
Voc (VDC):	68.2
Vmp (VDC):	57.3
Isc (A):	6.50
Imp (A):	6.11
Voc Temp Coeff (%/°C):	-0.29
Max Voltage (VDC):	1,000
Module Quantity:	532

Inverter #1-#3 Specifications

Model Number:	SOLECTRIA PVI 50TL
Nominal Power (kW AC):	50.00
Max App. Pwr (kVA AC):	55.00
Nominal AC Voltage (V):	480 (3/N/PE)
Max Output Current (A):	60.2
CEC Weighted Efficiency:	98.5%
Maximum DC Voltage (V):	1000
DC Start Voltage (V):	330
Min. MPPT Voltage (V):	480
MPPT Quantity:	3
Max Current MPPT A:	36.0
Max Current MPPT C:	36.0

PV AC System Summary

NOMINAL SYSTEM VOLTAGE:	480 Volts AC
MAX CURRENT PER 690.8(A):	181 Amps
MAX CURRENT PER 690.8(B):	226 Amps



PV System Maximum Voltage Calculation per NEC 690.7(A)

Local ASHRAE Min Temp:	-17 °C
Voc Temp Coefficient:	0.29%/°C
ASHRAE + 1:	1.122
Voc:	68.2
Correction Factor:	1.122
Max # of Modules in Series:	13
Temperature:	42°C
Corrected Open Circuit Voltage:	994.6 Volts DC

120% Rule Calculation per NEC 705.12(B)(2)(3)(b)

Main Busbar Rating:	1200 Amps
Main Service Breaker Rating:	1000 Amps
PV backfeeding Current:	225.75 Amps
BUSBAR x 120% - MAIN BREAKER = MAX ALLOWABLE PV CURRENT	1440 - 1000 = 440

NOTE: WHERE CONDUCTORS ARE INSTALLED IN PARALLEL, AN EG/GEC/GROUND CONDUCTOR MUST BE PRESENT IN EACH CONDUIT PER NEC 250.122(F).

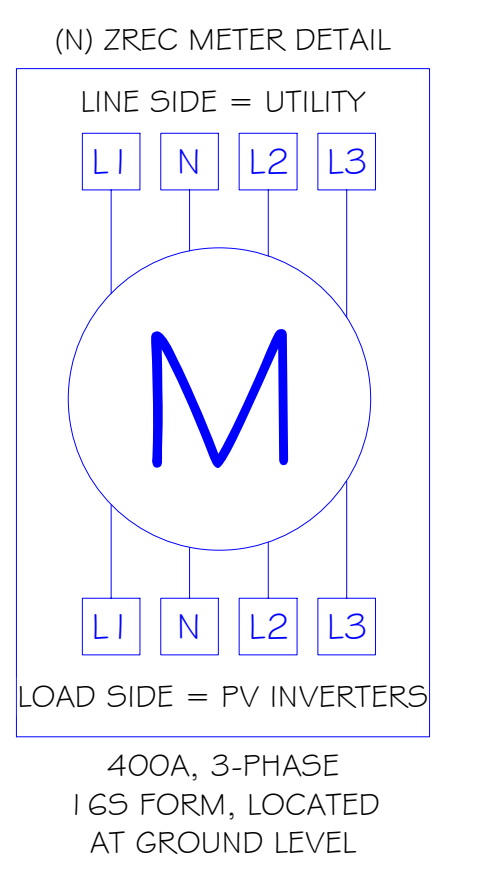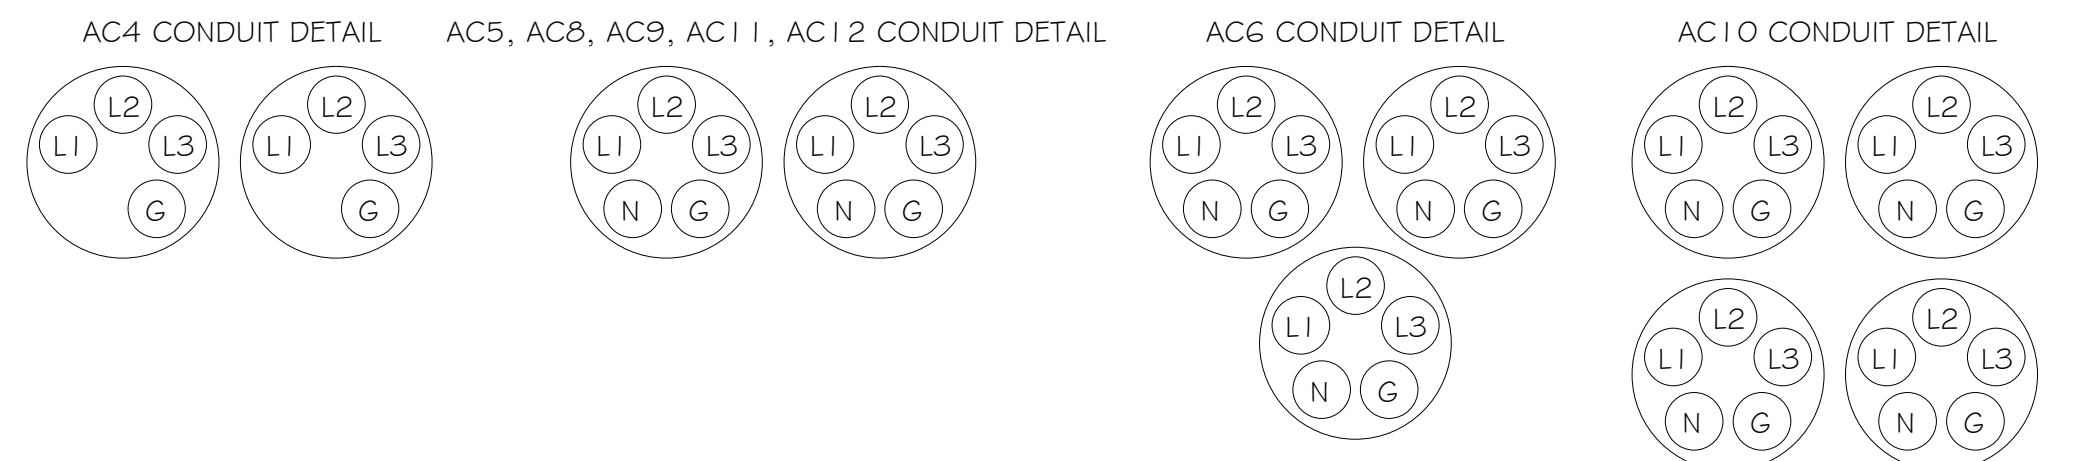

WIRE AND CONDUIT SCHEDULE

TAG	# OF PARALLEL CONDUITS	CONDUIT SIZE	CONDUIT TYPE	PHASE CONDUCTOR QTY, SIZE AND TYPE PER CONDUIT	NEUTRAL CONDUCTOR QTY, SIZE AND TYPE PER CONDUIT	GROUND CONDUCTOR QTY, SIZE AND TYPE PER CONDUIT	EST. DIST.
DC1	(1)	N/A	N/A	2/STRNG	AWG #10 PV-WIRE	N/A	1.35
DC2	(1)	1-1/4"	EMT	10	AWG #10 PV-WIRE	N/A	1.80
AC1	(1)	1-1/4"	EMT	3	AWG #3 XHHW-2	1 AWG #6 XHHW-2	1.0
AC2	(1)	3"	EMT	3	350 kcmil XHHW-2	1 AWG #2 XHHW-2	260
AC3	(1)	3"	SCH40 PVC	3	350 kcmil XHHW-2	1 AWG #2 XHHW-2	125
AC4	(1)	3"	EMT	3	250 kcmil THHN	0 N/A	25
AC5	(1)	3"	SCH40 PVC	3	250 kcmil THHN	1 AWG #2 THHN	25
AC6	(3)	3"	SCH40 PVC	3	AWG #4/0 XHHW-2	1 AWG #4/0 XHHW-2	25
AC7	(1)	3"	SCH40 PVC	3	AWG #4/0 XHHW-2	1 AWG #4/0 XHHW-2	25
AC8	(2)	3"	SCH40 PVC	3	AWG #4/0 XHHW-2	1 AWG #4/0 XHHW-2	25
AC9	(2)	3"	SCH40 PVC	3	AWG #4/0 XHHW-2	1 AWG #4/0 XHHW-2	25
AC10	(4)	3"	SCH40 PVC	3	AWG #4/0 XHHW-2	1 AWG #4/0 XHHW-2	25
AC11	(2)	3"	SCH40 PVC	3	AWG #4/0 XHHW-2	1 AWG #4/0 XHHW-2	340
AC12	(2)	3"	SCH40 PVC	3	AWG #4/0 XHHW-2	1 AWG #4/0 XHHW-2	440
AC13	(1)	3"	SCH40 PVC	3	AWG #4/0 XHHW-2	1 AWG #4/0 XHHW-2	340
AC14	(2)	3"	SCH40 PVC	3	300 kcmil XHHW-2	1 300 kcmil XHHW-2	440
AC15	(4)	4"	SCH40 PVC	3	500 kcmil XHHW-2	1 500 kcmil XHHW-2	25
AC16	(3)	4"	SCH40 PVC	3	400 kcmil THWN-2	1 400 kcmil THWN-2	25

CONDUIT FILL CALCULATIONS

TAG	CONDUCTOR AREA (SQ IN)	CONDUCTOR QTY	CONDUCTOR FILL (SQ IN)	NEUTRAL AREA (SQ IN)	NEUTRAL QTY	NEUTRAL FILL (SQ IN)	GROUND AREA (SQ IN)	GROUND QTY	GROUND FILL (SQ IN)	TOTAL WIRE FILL	CONDUIT TYPE	CONDUIT SIZE	CONDUIT AREA (SQ IN) x 40%	MAX CONDUIT FILL	CONDUIT FILL PERCENT	
DC1	0.0531	x N/A	= N/A	N/A	x 0	= 0.0000	0.0206	x 1	= 0.0206	N/A	N/A	N/A	x .4 =	N/A	N/A	
DC2	0.0531	x 10	= 0.5309	N/A	x 0	= 0.0000	0.0531	x 1	= 0.0531	0.5840	EMT	1-1/4"	1.496	x .4 =	0.5984	39.0%
AC1	0.0962	x 3	= 0.2886	0.0590	x 1	= 0.0590	0.0590	x 1	= 0.0590	0.4066	EMT	1-1/4"	1.496	x .4 =	0.5984	27.2%
AC2	0.5166	x 3	= 1.5498	0.1146	x 1	= 0.1146	0.1146	x 1	= 0.1146	1.7790	EMT	3"	8.846	x .4 =	3.5384	20.1%
AC3	0.5166	x 3	= 1.5498	0.1146	x 1	= 0.1146	0.1146	x 1	= 0.1146	1.7790	SCH40 PVC	3"	7.268	x .4 =	2.9072	24.5%
AC4	0.9970	x 3	= 2.9910	N/A	x 0	= 0.0000	0.1146	x 1	= 0.1146	1.3056	EMT	3"	8.846	x .4 =	3.5384	14.6%
AC5	0.9970	x 3	= 2.9910	0.1158	x 1	= 0.1158	0.1146	x 1	= 0.1146	1.4214	SCH40 PVC	3"	7.268	x .4 =	2.9072	19.6%
AC6	0.3197	x 3	= 0.9591	0.3197	x 1	= 0.3197	0.2190	x 1	= 0.2190	1.4978	SCH40 PVC	3"	7.268	x .4 =	2.9072	20.6%
AC7	0.3197	x 3	= 0.9591	0.3197	x 1	= 0.3197	0.0814	x 1	= 0.0814	1.3602	SCH40 PVC	3"	7.268	x .4 =	2.9072	18.7%
AC8	0.3197	x 3	= 0.9591	0.3197	x 1	= 0.3197	0.1534	x 1	= 0.1534	1.4322	SCH40 PVC	3"	7.268	x .4 =	2.9072	19.7%
AC9	0.3197	x 3	= 0.9591	0.3197	x 1	= 0.3197	0.1534	x 1	= 0.1534	1.4322	SCH40 PVC	3"	7.268	x .4 =	2.9072	19.7%
AC10	0.3197	x 3	= 0.9591	0.3197	x 1	= 0.3197	0.2642	x 1	= 0.2642	1.5430	SCH40 PVC	3"	7.268	x .4 =	2.9072	21.2%
AC11	0.3197	x 3	= 0.9591	0.3197	x 1	= 0.3197	0.1534	x 1	= 0.1534	1.4322	SCH40 PVC	3"	7.268	x .4 =	2.9072	19.7%
AC12	0.3197	x 3	= 0.9591	0.3197	x 1	= 0.3197	0.1534	x 1	= 0.1534	1.4322	SCH40 PVC	3"	7.268	x .4 =	2.9072	19.7%
AC13	0.3197	x 3	= 0.9591	0.3197	x 1	= 0.3197	0.0814	x 1	= 0.0814	1.3602	SCH40 PVC	3"	7.268	x .4 =	2.9072	18.7%
AC14	0.4536	x 3	= 1.3608	0.4536	x 1	= 0.4536	0.0814	x 1	= 0.0814	1.8958	SCH40 PVC	3"	7.268	x .4 =	2.9072	26.1%
AC15	0.6984	x 3	= 2.0952	0.6984	x 1	= 0.6984	0.2190	x 1	= 0.2190	3.0126	SCH40 PVC	4"	12.554	x .4 =	5.0216	24.0%
AC16	0.5863	x 3	= 1.7589	0.5863	x 1	= 0.5863	0.2223	x 1	= 0.2223	2.5675	SCH40 PVC	4"	12.554	x .4 =	5.0216	20.5%

REVISIONS

DESCRIPTION	DATE	REV
60% DELIVERABLE	11/29/2021	1
90% DELIVERABLE	12/10/2021	2
PERMIT SET	1/25/2022	A
AHJ COMMENTS	3/11/2022	B
NEW EQUIPMENT PAD	10/7/2022	C
AS-BUILTS	8/13/2024	D

Sheet Title:
ELECTRICAL DIAGRAM

Sheet Number:
E2.0

Sheet Size:
ARCH D - 36" x 24"

Design & Drafting by:
ALEXANDER MORAN
Alexander Moran

"Always remember: never accept the world as it appears to be. Dare to see it for what it could be."
- Harold Winston

Reviewed & Approved by:
RD

Array Configuration			
System: 186.2 kWstc, 150 kW AC			
Total PV Module Qty: 532			
Inverter I.D.#	Inv #1	Inv #2	Inv #3
Inverter AC Power (kW):	50.00	50.00	50.00
PV Power (kWstc):	60.20	63.00	63.00
Inverter DC:AC Ratio:	1.20	1.26	1.26
Module Total Qty:	172	180	180
String Qty:	5	5	5
String Length:	13	12	12
Max Open Circuit Voltage:	995	918	918
Min Open Circuit Voltage:	776	716	716
Max Operating Voltage:	730	674	674
Min Operating Voltage:	652	602	602
Max Short Circuit Current:	40.6	40.6	40.6
Operating Current:	30.6	30.6	30.6
String Qty:	5	5	5
String Length:	11	12	12
Max Open Circuit Voltage:	842	918	918
Min Open Circuit Voltage:	657	716	716
Max Operating Voltage:	618	674	674
Min Operating Voltage:	552	602	602
Max Short Circuit Current:	40.6	40.6	40.6
Operating Current:	30.6	30.6	30.6
String Qty:	4	5	5
String Length:	13	12	12
Max Open Circuit Voltage:	995	918	918
Min Open Circuit Voltage:	776	716	716
Max Operating Voltage:	730	674	674
Min Operating Voltage:	652	602	602
Max Short Circuit Current:	32.5	40.6	40.6
Operating Current:	24.4	30.6	30.6

PV Module Specifications			
Model Number:	SUNPOWER SPR-X21-350-BLK		
Weight (lbs):	41.0		
Dimensions (in):	61.3 x 41.2 x 1.8		
Power @ STC (W):	350		
Voc (VDC):	68.2		
Vmp (VDC):	57.3		
Voc Temp Coeff (%/°C):	-0.29		
Isc (A):	6.50		
Imp (A):	6.11		
Max Voltage (VDC):	1,000		
Module Quantity:	532		


Inverter #1 - #3 Specifications			
Model Number:	SOLETRIA PVI 50TL		
Nominal Power (kW AC):	50.00	Max App. Pwr (kVA AC):	55.00
Nominal AC Voltage (V):	480	(3/N/PE)	
Max Output Current (A):	60.2		
CEC Weighted Efficiency:	98.5%		
Maximum DC Voltage (V):	1000	Max Current MPPT A:	36.0
DC Start Voltage (VDC):	330	Max Current MPPT B:	36.0
Max. MPPT Voltage (V):	850	Max Current MPPT C:	36.0
Min. MPPT Voltage (V):	480		
MPPT Quantity:	3		
Inverter Quantity:	3		

PV System Maximum Voltage Calculation per NEC 690.7(A)			
Local ASHRAE Min Temp:	-17 °C		
Data Source:	WHITE PLAINS WESTCHESTER CO A		
Voc Temp Coefficient	25°C -	Voc	Temperature
Correction Factor	+ 1 =	Correction Factor	Temperature
1.22 x 68.2 x	13 =	1.122	994.6 Volts DC

PV AC System Summary	
NOMINAL SYSTEM VOLTAGE:	480 Volts AC
MAX CURRENT PER 690.8(A):	181 Amps
MAX CURRENT PER 690.8(B):	226 Amps

120% Rule Calculation per NEC 705.12(B)(2)(3)(b)		
Main Busbar Rating:	1200	Amps
Main Service Breaker Rating:	1000	Amps
PV Backfeeding Current:	225.75	Amps
BUSBAR x 120% - MAIN BREAKER =	MAX ALLOWABLE	PV CURRENT
1440 - 1000 =	440	

NOTE:
WHERE CONDUCTORS ARE INSTALLED IN PARALLEL,
AN EGC/GEC GROUND CONDUCTOR MUST BE
PRESENT IN EACH CONDUIT PER NEC 250.122(F).

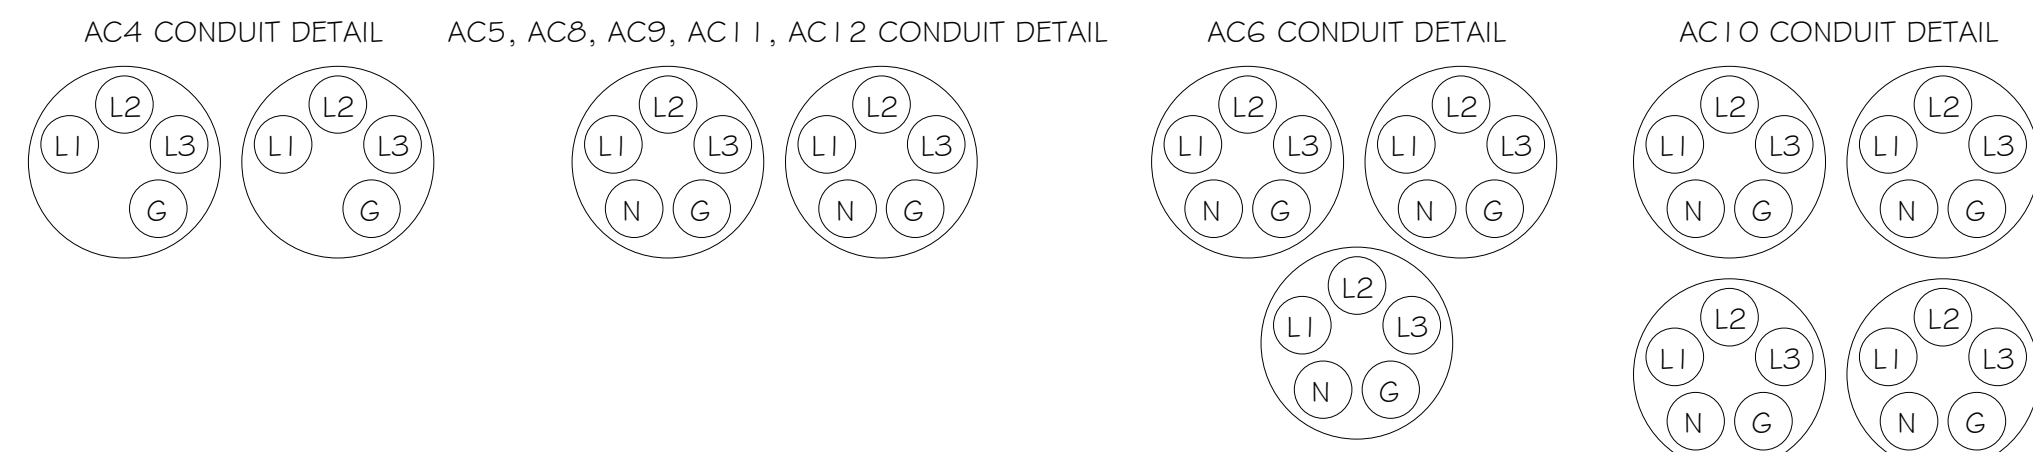

WIRE AND CONDUIT SCHEDULE									
TAG	# OF PARALLEL CONDUITS	CONDUIT SIZE	CONDUIT TYPE	PHASE CONDUCTOR QTY, SIZE AND TYPE PER CONDUIT	NEUTRAL CONDUCTOR QTY, SIZE AND TYPE PER CONDUIT	GROUND CONDUCTOR QTY, SIZE AND TYPE PER CONDUIT	EST. DIST.		
DC1	(1)	N/A	N/A	2/STRING AWG #10 PV-WIRE	N/A	N/A	135		
DC2	(1)	1-1/4"	EMT	10 AWG #10 PV-WIRE	N/A	N/A	180		
AC1	(1)	1-1/4"	EMT	3 AWG #3 XHHW-2	1 AWG #6 XHHW-2	1 AWG #6 XHHW-2	10		
AC2	(1)	3"	EMT	3 350 kcmil XHHW-2	1 AWG #2 XHHW-2	1 AWG #2 XHHW-2	280		
AC3	(1)	3"	SCH40 PVC	3 350 kcmil XHHW-2	1 AWG #2 XHHW-2	1 AWG #2 XHHW-2	125		
AC4	(1)	3"	EMT	3 250 kcmil THHN	0 N/A	N/A	25		
AC5	(1)	3"	SCH40 PVC	3 250 kcmil THHN	1 AWG #2 THHN	1 AWG #2 XHHW-2	25		
AC6	(3)	3"	SCH40 PVC	3 AWG #4/0 XHHW-2	1 AWG #4/0 XHHW-2	1 AWG #2/0 XHHW-2	25		
AC7	(1)	3"	SCH40 PVC	3 AWG #4/0 XHHW-2	1 AWG #4 XHHW-2	1 AWG #4 XHHW-2	25		
AC8	(2)	3"	SCH40 PVC	3 AWG #4/0 XHHW-2	1 AWG #4/0 XHHW-2	1 AWG #1 XHHW-2	25		
AC9	(2)	3"	SCH40 PVC	3 AWG #4/0 XHHW-2	1 AWG #4/0 XHHW-2	1 AWG #1 XHHW-2	25		
AC10	(4)	3"	SCH40 PVC	3 AWG #4/0 XHHW-2	1 AWG #4/0 XHHW-2	1 AWG #3/0 XHHW-2	25		
AC11	(2)	3"	SCH40 PVC	3 AWG #4/0 XHHW-2	1 AWG #4/0 XHHW-2	1 AWG #1 XHHW-2	340		
AC12	(2)	3"	SCH40 PVC	3 AWG #4/0 XHHW-2	1 AWG #4/0 XHHW-2	1 AWG #1 XHHW-2	440		
AC13	(1)	3"	SCH40 PVC	3 AWG #4/0 XHHW-2	1 AWG #4/0 XHHW-2	1 AWG #4 XHHW-2	340		
AC14	(2)	3"	SCH40 PVC	3 300 kcmil XHHW-2	1 300 kcmil XHHW-2	1 AWG #4 XHHW-2	440		
AC15	(4)	4"	SCH40 PVC	3 500 kcmil XHHW-2	1 500 kcmil XHHW-2	1 AWG #2/0 XHHW-2	25		
AC16	(3)	4"	SCH40 PVC	3 400 kcmil THWN-2	1 400 kcmil THWN-2	1 AWG #2/0 THWN-2	25		

CONDUIT FILL CALCULATIONS																
TAG	CONDUCTOR AREA (SQ IN)	CONDUCTOR QTY	CONDUCTOR FILL (SQ IN)	NEUTRAL AREA (SQ IN)	NEUTRAL QTY	NEUTRAL FILL (SQ IN)	GROUND AREA (SQ IN)	GROUND QTY	GROUND FILL (SQ IN)	TOTAL WIRE FILL	CONDUIT TYPE	CONDUIT SIZE	CONDUIT AREA (SQ IN) x 40% =	MAX CONDUIT FILL	CONDUIT FILL PERCENT	
DC1	0.0531	x 10	= 0.5309	N/A	x 0	= 0.0000	0.0206	x 1	= 0.0206	N/A	N/A	N/A	N/A	x 4 =	N/A	N/A
DC2	0.0531	x 10	= 0.5309	N/A	x 0	= 0.0000	0.0531	x 1	= 0.0531	0.5840	EMT	1-1/4"	1.496	x 4 =	0.5984	39.0%
AC1	0.0962	x 3	= 0.2886	0.0590	x 1	= 0.0590	0.0590	x 1	= 0.0590	0.4066	EMT	1-1/4"	1.496	x 4 =	0.5984	27.2%
AC2	0.5166	x 3	= 1.5498	0.1146	x 1	= 0.1146	0.1146	x 1	= 0.1146	1.7790	EMT	3"	8.846	x 4 =	3.5384	20.1%
AC3	0.5166	x 3	= 1.5498	0.1146	x 1	= 0.1146	0.1146	x 1	= 0.1146	1.7790	SCH40 PVC	3"	7.268	x 4 =	2.9072	24.5%
AC4	0.3970	x 3	= 1.1910	N/A	x 0	= 0.0000	0.1146	x 1	= 0.1146	1.3056	EMT	3"	8.846	x 4 =	3.5384	14.8%
AC5	0.3970	x 3	= 1.1910	0.1158	x 1	= 0.1158	0.1146	x 1	= 0.1146	1.4214	SCH40 PVC	3"	7.268	x 4 =	2.9072	19.6%
AC6	0.3197	x 3	= 0.9591	0.3197	x 1	= 0.3197	0.2190	x 1	= 0.2190	1.4978	SCH40 PVC	3"	7.268	x 4 =	2.9072	20.6%
AC7	0.3197	x 3	= 0.9591	0.3197	x 1	= 0.3197	0.0814	x 1	= 0.0814	1.3602	SCH40 PVC	3"	7.268	x 4 =	2.9072	18.7%
AC8	0.3197	x 3	= 0.9591	0.3197	x 1	= 0.3197	0.1534	x 1	= 0.1534	1.4322	SCH40 PVC	3"	7.268	x 4 =	2.9072	19.7%
AC9	0.3197	x 3	= 0.9591	0.3197	x 1	= 0.3197	0.1534	x 1	= 0.1534	1.4322	SCH40 PVC	3"	7.268	x 4 =	2.9072	19.7%
AC10	0.3197	x 3	= 0.9591	0.3197	x 1	= 0.3197	0.2642	x 1	= 0.2642	1.5430	SCH40 PVC	3"	7.268	x 4 =	2.9072	21.2%
AC11	0.3197	x 3	= 0.9591	0.3197	x 1	= 0.3197	0.1534	x 1	= 0.1534	1.4322	SCH40 PVC	3"	7.268	x 4 =	2.9072	19.7%
AC12	0.3197	x 3	= 0.9591	0.3197	x 1	= 0.3197	0.1534	x 1	= 0.1534	1.4322	SCH40 PVC	3"	7.268	x 4 =	2.9072	19.7%
AC13	0.3197	x 3	= 0.9591	0.3197	x 1	= 0.3197	0.0814	x 1	= 0.0814	1.3602	SCH40 PVC	3"	7.268	x 4 =	2.9072	18.7%
AC14	0.4536	x 3	= 1.3608	0.4536	x 1	= 0.4536	0.0814	x 1	= 0.0814	1.8958	SCH40 PVC	3"	7.268	x 4 =	2.9072	26.1%
AC15	0.6984	x 3	= 2.0952	0.6984	x 1	= 0.6984	0.2190	x 1	= 0.2190	3.0126	SCH40 PVC	4"	12.554	x 4 =	5.0216	24.0%
AC16	0.5863	x 3	= 1.7589	0.5863	x 1	= 0.5863	0.2223	x 1	= 0.2223	2.5675	SCH40 PVC	4"	12.554	x 4 =	5.0216	20.5%

TAG	CIRCUIT ORIGIN	CIRCUIT DESTINATION	CONDUCTOR SPECIFICATIONS			REQUIRED CONDUCTOR AMPACITY			AMPCACITY CHECK #1	CONDUCTOR TEMPERATURE DERATING			CONDUIT FILL DERATING	CORRECTED AMPACITY CALCULATION		AMPCACITY CHECK #2	VOLTAGE DROP								
			MATERIAL	CONN. TEMP. RATING	TRADE SIZE	AMPCACITY PER 310.15(B)(16) & 310.15(B)(17)	MAX CURRENT PER 690.8(A)(1)	Isc	# OF STRINGS	MAX OPERATION CURRENT PER 690.8(A)(1)	CONT. OPERATION CURRENT PER 690.8(B)(1)	MAX CURRENT PER 690.8(B)(1)	CIRCUIT ENVIRONMENT	LOCAL 2% AVG. HIGH TEMP (°C)	HEIGHT ABOVE ROOF (in)	TEMP. ADJ. PER 310.15(B)(3)(c)	EXPECTED OPERATING TEMP (°C)	AMPCACITY CORRECTION 310.15(B)(2)(a)	# OF UNGROUNDED CONDUCTORS	AMPCACITY CORRECTION 310.15(B)(3)(a)	90°C CONDUCTOR AMPACITY	TEMP DERATE	CONDUIT FILL	DERATED CONDUCTOR AMPACITY	MAX CURRENT PER 690.8(B)(2)
DC1	PV STRING	JUNCTION BOX	COPPER	90°C	AWG #10	55 Amps	1.25	x 6.50	x 1 = 8.1 Amps	x 1.25 = 10.1 Amps	10.1 Amps < 55.0 Amps	ROOFTOP, FREE AIR	32	-	N/A	32	0.96	N/A	1.00	55	x 0.96	x 1.00 = 52.8 Amps	8.1 Amps < 52.8 Amps	135 ft	0.44%
DC2	JUNCTION BOX	INVERTER	COPPER	75°C	AWG #10	35 Amps	1.25	x 6.50	x 1 = 8.1 Amps	x 1.25 = 10.1 Amps	10.1 Amps < 35.0 Amps	ROOFTOP, IN CONDUIT	32	1	0	32	0.96	10	0.50	40	x 0.96	x 0.50 = 19.2 Amps	8.1 Amps < 19.2 Amps	180 ft	0.56%

TAG	CIRCUIT ORIGIN	CIRCUIT DESTINATION	CONDUCTOR SPECIFICATIONS			REQUIRED CONDUCTOR AMPACITY			AMPCACITY CHECK #1	CONDUCTOR TEMPERATURE DERATING			CONDUIT FILL DERATING	CORRECTED AMPACITY CALCULATION		AMPCACITY CHECK #2	VOLTAGE DROP						
			MATERIAL	TERMINAL TEMP. RATING	TRADE SIZE	NUMBER OF PARALLEL CONDUCTORS	AMPCACITY PER 310.15(B)(16) & 310.15(B)(17)	INVERTER OUTPUT CURRENT	# OF INVERTERS	MAX OPERATION CURRENT PER 690.8(A)(3)	CONT. OPERATION CURRENT PER 690.8(B)(1)	MAX CURRENT PER 690.8(B)(1)	CIRCUIT ENVIRONMENT	LOCAL 2% AVG. HIGH TEMP (°C)	EXPECTED OPERATING TEMP (°C)	AMPCACITY CORRECTION 310.15(B)(2)(a)	# OF UNGROUNDED CONDUCTORS	AMPCACITY CORRECTION 310.15(B)(3)(a)	90°C CONDUCTOR AMPACITY	TEMP DERATE	CONDUIT FILL	DERATED CONDUCTOR AMPACITY	MAX CURRENT PER 690.8(B)(2)
AC1	INVERTER	AC COMBINER PANEL	ALUM	75°C	AWG #3	1	75 Amps	60.2	x 1 = 60.2 Amps	x 1.25 = 75.3 Amps	75.3 Amps > 75 Amps	EXT. BLDG. WALL (+15°C)	32	47	0.82	3	1.00	85	x 0.82	x 1.00 = 69.7 Amps	60.2 Amps < 69.7 Amps	10 ft	0.09%
AC2	AC COMBINER PANEL	AC DISCONNECT	ALUM	75°C	350 kcmil	1	250 Amps	60.2	x 3 = 180.6 Amps	x 1.25 = 225.8 Amps	225.8 Amps < 250 Amps	INDOORS (+0°C)	32	32	0.96	3	1.00	280	x 0.96	x 1.00 = 268.8 Amps	180.6 Amps < 268.8 Amps	280 ft	1.11%
AC3	AC DISCONNECT	GENERATION PANEL	ALUM	75°C	350 kcmil	1	250 Amps	60.2	x 3 = 180.6 Amps	x 1.25 = 225.8 Amps	225.8 Amps < 250 Amps	UNDERGROUND (+0°C)	32	32	0.96	3	1.00	280	x 0.96	x 1.00 = 268.8 Amps	180.6 Amps < 268.8 Amps	125 ft	0.49%
AC4	STORAGE SYSTEM	ISOLATION XFMR	COPPER	75°C	250 kcmil	1	255 Amps	150.0	x 3 = 150.0 Amps	x 1.25 = 187.5 Amps	187.5 Amps < 255 Amps	DIRECT SUNLIGHT (+15°C)	32	47	0.82	3	1.00	290	x 0.82	x 1.00 = 237.8 Amps	150.0 Amps < 237.8 Amps	25 ft	0.07%
AC5	ISOLATION XFMR	GENERATION PANEL	COPPER	75°C	250 kcmil	1	255 Amps	150.0	x 3 = 150.0 Amps	x 1.25 = 187.5 Amps	187.5 Amps < 255 Amps	UNDERGROUND (+0°C)	32	32	0.96	3	1.00	290	x 0.96	x 1.00 = 278.4 Amps	150.0 Amps < 278.4 Amps	25 ft	0.07%

TAG	CIRCUIT ORIGIN	CIRCUIT DESTINATION	CONDUCTOR SPECIFICATIONS			CONDUCTOR TEMPERATURE DERATING			CONDUIT FILL DERATING	CORRECTED AMPACITY CALCULATION		AMPCACITY CHECK	VOLTAGE DROP	



SUNPOWER®

SunPower X-Series: X21-350-BLK

SunPower® Residential DC Panel


SunPower X-Series panels combine the top efficiency, durability and warranty available in the market today, resulting in more long-term energy and savings.^{1,2}

Premium Aesthetics

SunPower® Signature™ Black X-Series panels blend harmoniously into your roof. The most elegant choice for your home.


Highest Lifetime Energy and Savings

Designed to deliver 60% more energy in the same space over 25 years in real-world conditions like partial shade and high temperatures.^{1,2}

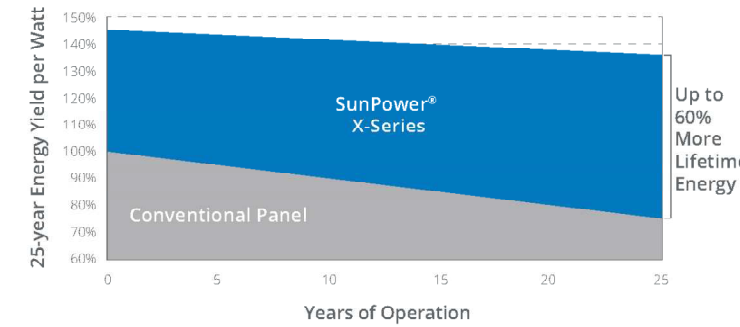

Best Reliability, Best Warranty

With more than 25 million panels deployed around the world, SunPower technology is proven to last. That's why we stand behind our panel with the industry's best 25-year Combined Power and Product Warranty, including the highest Power Warranty in solar.

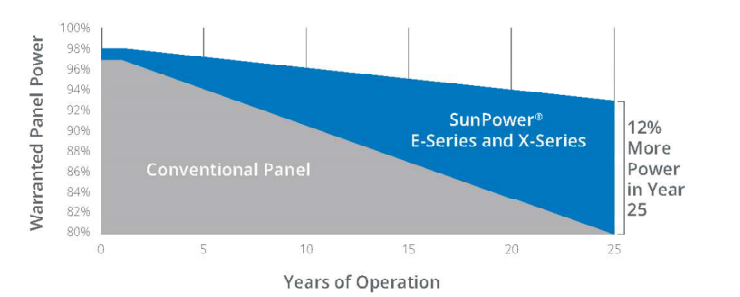


Fundamentally Different. And Better.



The SunPower Maxeon® Solar Cell

- Enables highest efficiency panels available^{1,2}
- Unmatched reliability³
- Patented solid metal foundation prevents leakage and corrosion

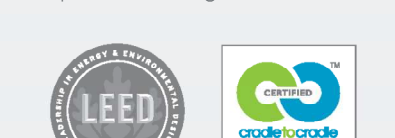

As Sustainable As Its Energy

- Ranked #1 in Silicon Valley Toxic Coalition 2015 Solar Scorecard⁴
- First solar panels to achieve Cradle to Cradle Certified™ Silver recognition⁵
- Contributes to more LEED categories than conventional panels⁶

X-Series: X21-350-BLK SunPower® Residential DC Panel

Electrical Data	SFP-X21-350-BLK	SFP-X21-325-BLK
Nominal Power (P _{nom}) ¹	350 W	325 W
Power Tolerance	+50%	+50%
Panel Efficiency	21.5%	20.6%
Rated Voltage (V _{mp})	57.3 V	57.3 V
Rated Current (I _{mp})	6.11 A	5.65 A
Open-Circuit Voltage (V _{oc})	68.2 V	67.9 V
Short-Circuit Current (I _{sc})	6.50 A	6.23 A
Max. System Voltage	600 V UL & 1000 V IEC	
Maximum Series Fuse	15 A	
Power Temp. Coef.	-0.29%/°C	
Voltage Temp. Coef.	-167.4 mV/°C	
Current Temp. Coef.	2.9 mA/°C	

Operating Condition And Mechanical Data	
Temperature	-40°F (-40°C) to +135°F (+57°C)
Impact Resistance	1 inch (25 mm) diameter hail at 52 mph (23 m/s)
Appearance	Class A
Solar Cells	96 Monocrystalline Maxeon Gen III
Tempered Glass	High transmission tempered anti-reflective
Junction Box	IP-65, MC4 compatible
Weight	41 lbs (18.6 kg)
Max. Load	G5 Frame: Wind 62 psf, 3000 Pa front & back Snow 1.25 psf, 6000 Pa front G3 Frame: Wind 50 psf, 2400 Pa front & back Snow 1.12 psf, 5400 Pa front
Frame	Class 1 black anodized (highest AAMA rating)

Tests And Certifications	
Standard Tests ¹	UL 1703 (Type 2 Fire Rating), IEC 61215, IEC 61730
Quality Management Certs	ISO 9001:2015, ISO 14001:2015
EHS Compliance	RoHS, OHSAS 18001:2007, lead free, Recycle Scheme, REACH SVHC-163
Sustainability	Cradle to Cradle Certified™ Silver "Declare" listed
Ammonia Test	IEC 62716
Desert Test	101109/PPSC/2013.6744437
Salt Spray Test	IEC 61701 (maximum severity)
PID Test	1000V, IEC 62804, PVEL 600 hr duration
Available Listings	UL, TLV, MCS, PSE, CFC

¹ SunPower 360 W compared to a Conventional Panel on same-sized array (260 W, 16% efficient, approx. 1.5 m² more energy per watt) based on PVGIS per Watt (0.75kW/m² slower degradation) (Campese, Z. et al, "SunPower Module Degradation Rate" SunPower white paper, 2013).

² Based on search of datasheet values from websites of top 10 manufacturers per ILS, et al of January 2017.

³ #1 rank in "Transformer PV Durability Initiative for Solar Installers Part 5: PV Panel Panel" Magazine, 2015, Campese, Z. et al, "SunPower Module Degradation Rate" SunPower white paper, 2013.

⁴ SunPower is rated #1 on Silicon Valley Toxics Coalition's Solar Scorecard.

⁵ Cradle to Cradle Certified is a multi-attribute certification program that assesses products and materials for safety to human and environmental health, design for future use cycles, and sustainable manufacturing.

⁶ X-Series and E-Series panels additionally contribute to LEED Materials and Resources credit categories.

⁷ Standard Test Conditions (1000 W/m² irradiance, AM 1.5, 25°C) NREL calibration standard (SM) current, LACC, FF and voltage.

⁸ Type 2 fire rating per UL 7103/2013, Class C rating per UL 7103/2002.

See www.sunpower.com for more reference information. For more details, see extended datasheets, www.sunpower.com resources. Specifications included in this datasheet are subject to change without notice.

©2018 SunPower Corporation. All rights reserved. SUNPOWER, the SUNPOWER logo, MAXEON, SIGNATURE and InviMount are trademarks or registered trademarks of SunPower Corporation.

1-800-SUNPOWER

527835 Rev A / LTR_US

SUNPOWER®

YASKAWA

PVI 50TL & PVI 60TL

3-Ph Transformerless Commercial String Inverters



Features

- Integrated arc fault protection
- UL 1741 SA listed
- 3 MPPTs with 5 inputs each
- Integrated DC and AC disconnects
- AC terminals compatible with copper and aluminum conductors
- Modbus communications
- Internal data logger
- 0 - 90° installation orientation
- Remote firmware upgrades
- Remote diagnostics
- Compatible with certain MLPE for module-level rapid shutdown

Options

- Shade cover
- DC fuse bypass
- Web-based monitoring

Yaskawa Solecrista Solar's PVI 50TL and PVI 60TL are grid-tied, transformerless three-phase inverters designed for ground mount, rooftop and carport arrays and can be installed from 0 - 90 degrees. The PVI 50/60TL inverters are the most reliable, efficient and cost effective in their class. They come standard with AC and DC disconnects, three MPPTs, a 15-position string combiner, remote diagnostics, remote firmware upgrades and various protection features. Options include shade cover, DC combiner fuse bypass, and web-based monitoring.

PVI 50TL & PVI 60TL

Specifications

	PVI 50TL	PVI 60TL
DC Input		
Absolute Maximum Input Voltage	1000 VDC	1000 VDC
Maximum Power Input Voltage Range (MPPT)	480-960 VDC	480-960 VDC
Operating Voltage Range (MPPT)	200-960 VDC	200-960 VDC
Maximum Operating Input Current	108 A (38 A per MPPT)	114 A (38 A per MPPT)
Number of MPPTs	3	3
Maximum Available PV Current (ISC x 1.25)	204 A (68 A per MPPT)	204 A (68 A per MPPT)
Maximum PV Power	75 kW (25 kW per MPPT)	90 kW (30 kW per MPPT)
Start Voltage	300 V	300 V
AC Output		
Nominal Output Voltage	480 VAC, 3-Phase	480 VAC, 3-Phase
AC Voltage Range (Standard)	±12% (475-495 VAC)	±12% (475-495 VAC)
PF=1.00 - Pass/Active Power/Output Current	85 kW / 50 kVA / 60.2 A	85 kW / 60 kVA / 72.5 A
PF=-0.91 - Pass/Active Power/Output Current	50 kW / 50 kVA / 66.2 A	60 kW / 60 kVA / 79.4 A
Nominal Output Frequency	60 Hz	60 Hz
Output Frequency Range	57.45 Hz	57.45 Hz
Power Factor	Unity, >0.99 (Adjustable 0.8 leading to 0.8 lagging)	Unity, >0.99 (Adjustable 0.8 leading to 0.8 lagging)
Total Harmonic Distortion (THD) @ Rated Load	<3%	<3%
Recommended OCPD Device	90 A	100 A
AC Surge Protection	Type II MOV, 1240V, 15kA (60/25)	
Efficiency		
Peak Efficiency	99.0%	99.0%
CFD Efficiency	98.5%	98.5%
Line Loss	< 2 W	< 2 W
Integrated String Combiner		
Fused Inputs	15 Fused Positions (5 Positions per MPPT) 15 A Standard (20, 25, 30 A accepted)**	
Temperature		
Ambient Temperature Range	-20°F to +140°F (-30°C to +60°C); Derating occurs over +120°F (+50°C)	
Storage Temperature Range	No low temp minimum to +158°F (+70°C)	
Relative Humidity (non-condensing)	0-95%	
Operating Altitude	13,125 ft (4,000 m) Derating occurs from 9,842.5 ft (3,000 m)	
Communications		
Modbus Protocol	Standard	SunSpec: PVI (1.0) w/ Proprietary
SolarView Web-Based Monitoring Service	Optional	Optional: External
Remote Upgrade Monitoring	Optional: External	Optional: External
Remote Firmware Upgrades	Standard	Standard
Remote Diagnostics	Standard	Standard
Features & Protections		
Arc-Fault	Standard	Standard
Smart Grid Features	LHVRT, LHFRV, Volt. Var. Frequency-Watt and Volt. Watt, Soft-Start, Soft-Stop	
Testing & Certifications		
Safety Listings & Certifications	UL 1741SA-2016, UL 60961, CSA-C22.2 #107.1, IEEE 1547a-2014	
Advanced Grid Support Functionality	Rule 51, UL 1741SA	
Communication Interfacing	CSA	
FCC Compliance	FCC Part 15	
Warranty		
Standard Limited Warranty	10 Years	
Enclosure		
Acoustic Noise Rating	< 60 dBA @ 1 m at room temperature	
AGCC Disconnect	Standard, fully integrated	
Miswiring Angles**	0-90° from horizontal (vertical, angles, flat)	
Dimensions (H x W x D)	38.4 in. x 23.8 in. x 10.2 in. (1,000 mm x 600 mm x 260 mm)	
Inverter	123.5 lbs (56 kg); Wiring Box: 33 lbs (15 kg)	
Weight	Type 40, Polyester Powder Coated Aluminum	

**These inverters are compatible with SolarEdge's Module Level Power Electronics (MLPE). **Yaskawa Solecrista Solar does not supply optional fuses sizes. **Shade cover necessary required for installation of 75° or less.

SOLECRIA SOLAR

Yaskawa Solecrista Solar
360 Westinack Street
Lawrence, MA 01843
solecrista.com

1-978-683-9700
inverters@solecrista.com

DOCR 010642-S | November 2019
© 2019 Yaskawa Solecrista Solar

YASKAWA



Raising the bar in innovative DC MLPE solar power systems

RSD-S-PLC

- Meets NEC 2017 & 2020 (800.12) requirements
- Executes rapid shutdown of system when Transmitter-PLC signal is absent
- Meets SunSpec requirements

The RSD-S-PLC meets SunSpec requirements, maintaining normal function by continually receiving a heartbeat signal from the APsmart Transmitter. The RSD executes rapid system shutdown when the Transmitter signal is absent. Users can manually execute rapid shutdown using Transmitter breaker switch.

RSD-S-PLC TECHNICAL DATA


MODEL	RSD-S-PLC
INPUT DATA (DC)	
Input Operating Voltage Range	8-80V
Maximum Cont. Input Current (I _{max})	15A
Maximum Short Circuit Current (I _{sc})	25A
OUTPUT DATA (DC)	
Output Operating Voltage Range	8-80V
Maximum System Voltage	1000V/1500V
Maximum Series Fuse Rating	30A
MECHANICAL DATA	
Operating Ambient Temperature Range	-40°F to +185°F (-40°C to +85°C)
Dimensions (without cable & connectors)	5" x 1.2" x 0.61(129 mm x 30 mm x 16 mm)
Cable Length	Input 250mm/Output 1200mm
Cable Cross Section Size	UL-12AWG
Connector	Stübi MC4 PV-KBT48KST4 or Customize
Enclosure Rating	NEMA Type 6P/IP68
Over Temperature Protection	Yes
FEATURES & COMPLIANCE	
Communication	PLC
Safety Compliance	NEC 2017 & 2020 (690.12); UL1741; CSA C22.2 No. 330-17; IEC/EN62109-1; 2PFG2305
EMC Compliance	FCC Part15; ICES-003/IEC/EN61000-6-1/-2/-3/-4

© All Rights Reserved


REV 2.3 2021-11-12



RSD-S-PLC WIRING DIAGRAM

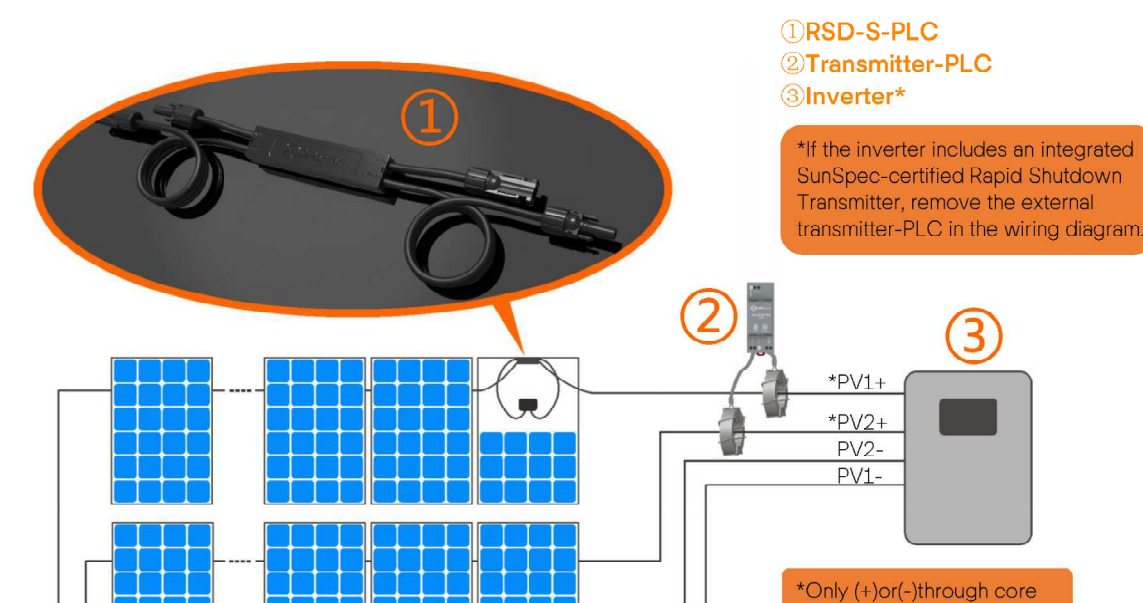

WORKING SCHEMATIC DIAGRAM

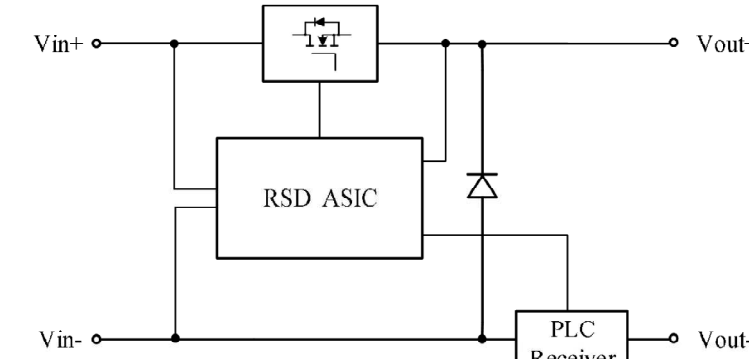

ORDERING INFORMATION

415002	1500V UL, 1.2m cable, Stübi MC4 PV-KBT48KST4
415001	1000V UL, 1.2m cable, Customized connector

APsmart

600 Erickson Ave NE, Suite 200 Seattle, WA 98110 | +1-737-218-8486 | +1-866-374-8538 | support@APsmartGlobal.com | APsmartGlobal.com

REV 2.3 2021-11-12

MG Series Technical Specifications

	MG30	MG125	MG250	MG500	MG1000
Three Phase Operation					
AC Voltage	480 VAC	480 VAC	480 VAC	480 VAC	480 VAC
AC Input/Output Current	36A	150A	300A	600A	1255A
AC Output Power (Discharge)	30kW	125kW	250kW	500kW	1000kW
AC Input Power (Charge)	30kW	125kW	250kW	500kW	1000kW
Battery Capacity	78kWh	220kWh	660kWh	1,100kWh	2,640kWh
AC Frequency (Field Settable)	60 Hz	60 Hz	50/60 Hz	50/60 Hz	50/60 Hz
MAX AC Overcurrent Protection	200A	250A	400A	800A	1600A
Peak Efficiency	97%	97%	97%	97%	97%
AC Connection	3 Phase, 3 Wire	3 Phase, 3 Wire	3 Phase, 3 Wire	3 Phase, 3 Wire	3 Phase, 3 Wire
Equipment Specifications					
External Dimensions (L x W x H)	60" x 36" 84"	60" x 36" 104"	124" x 75" 111"	170" x 75" x 111" (201" length includes HVAC)	(2) 170" x 75" x 111" (201" with HVAC) + TBV
Weight	4,300 lbs.	5,500 lbs.	17,000 lbs.	25,000 lbs.	56,000 lbs.
Lifting Provisions	Pallet Jack/Fork Lift	Fork Lift Slots	Fork Lift Slots	Fork Truck or Lift Strap	Fork Truck or Lift Strap
Paint Tested	1000 Salt Hour Spray	1000 Salt Hour Spray	1000 Salt Hour Spray	1000 Salt Hour Spray	1000 Salt Hour Spray
Fire Suppression	3M Novec 1230	3M Novec 1230	Hybrid - 3M Novec 1230 Dry Pipe Water	Hybrid - 3M Novec 1230 Dry Pipe Water	Hybrid - 3M Novec 1230 Dry Pipe Water
Handles	Stainless Steel Lockable	Stainless Steel Lockable	Reversible/Lockable	Reversible/Lockable	Reversible/Lockable
Temperature Range	-20°C to 50°C	-20°C to 50°C	-20°C to 50°C	-20°C to 50°C	-20°C to 50°C
MG Series Expansion Modules					
Max kWh	156kWh	220kWh	880kWh	1,320kWh	1,320kWh
External Dimensions (L x W x H)	60" x 36" 84"	60" x 36" 104"	124" x 75" 106"	170" x 75" x 111" (201" length includes HVAC)	170" x 75" x 111" (201" length includes HVAC)
Weight	4,050 lbs.	5,250 lbs.	16,750 lbs.	25,000 lbs.	28,000 lbs.
Lifting Provisions	Pallet Jack/Fork Lift	Fork Lift Slots	Fork Lift Slots	Fork Truck or Lift Strap	Fork Truck or Lift Strap
Paint Tested	1000 Salt Hour Spray	1000 Salt Hour Spray	1000 Salt Hour Spray	1000 Salt Hour Spray	1000 Salt Hour Spray
Fire Suppression	3M Novec 1230	3M Novec 1230	Hybrid - 3M Novec 1230 Dry Pipe Water	Hybrid - 3M Novec 1230 Dry Pipe Water	Hybrid - 3M Novec 1230 Dry Pipe Water
Handles	Stainless Steel Lockable	Stainless Steel Lockable	Reversible/Lockable	Reversible/Lockable	Reversible/Lockable
Temperature Range	-20°C to 50°C	-20°C to 50°C	-20°C to 50°C	-20°C to 50°C	-20°C to 50°C

ALL MG SERIES PRODUCTS

Control Software		
ELM Autonomous MicroGrid Site Control System	<input checked="" type="checkbox"/>	
Access & Alerts on Desktop & Mobile 24/7	<input checked="" type="checkbox"/>	
Asset Monitoring System Level & Individual	<input checked="" type="checkbox"/>	
Individual Microgrid Component Pages	<input checked="" type="checkbox"/>	
Local HMI IP 65 Touchscreen	<input checked="" type="checkbox"/>	
Communications: Wifi, Ethernet, Cellular	<input checked="" type="checkbox"/>	
Operation Parameters		
Islanded Mode	<input checked="" type="checkbox"/>	Off Grid Applications
Grid Tied Mode	<input checked="" type="checkbox"/>	Peak Shaving Backup Power Demand Response
Distributed Generation	<input checked="" type="checkbox"/>	Time of Use Operation
Key System Components		
NEMA 3R Enclosure	<input checked="" type="checkbox"/>	
Bi Directional Storage Inverter	<input checked="" type="checkbox"/>	
DC Disconnect (Battery)	<input checked="" type="checkbox"/>	
AC Disconnect (Inverter)	<input checked="" type="checkbox"/>	
AC Disconnect (Utility Interconnect)	<input checked="" type="checkbox"/>	
AC Circuit Breaker (Load Panel)	<input checked="" type="checkbox"/>	
PV Disconnect	<input checked="" type="checkbox"/>	
Utility Disconnect	<input checked="" type="checkbox"/>	
Climate Controls	<input checked="" type="checkbox"/>	
Certifications		
Batteries	UL 1973, UL 9540A	
Inverter	UL 1741 SA	
System	UL 9540	

Contractor:

Project:
404 TACONIC MICROGRID

Project Details:
186.20 kWdc, 150.00 kW AC

Engineering Approval:

REVISIONS

DESCRIPTION	DATE	REV
60% DELIVERABLE	11/29/2021	1
90% DELIVERABLE	12/10/2021	2
PERMIT SET	1/25/2022	A
AHJ COMMENTS	3/11/2022	B
NEW EQUIPMENT PAD	10/7/2022	C
AS-BUILTS	8/13/2024	D

Sheet Title:

EQUIPMENT DATA SHEETS

Sheet Number:

D.I.O

Sheet Size:

ARCH D - 36" x 24"

Design & Drafting by:

ALEXANDER MORAN
Alexander Moran
"Always remember: never accept the world as it appears to be. Dare to see it for what it could be."
- Harold Winston

Reviewed & Approved by:

RD